


Give All Information Completely
Make Required Affidavit
Mail or Deliver Report to:
Conservation Division
State Corporation Commission
211 No. Broadway
Wichita, Kansas

WELL PLUGGING RECORD

T-13 NORTH R-10W

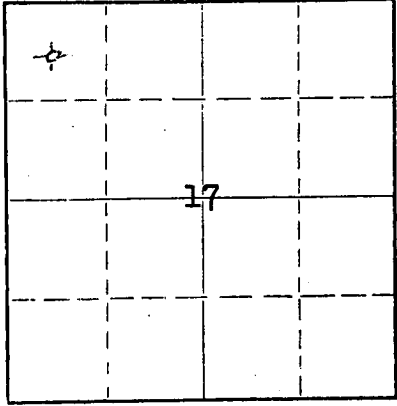

Locate well correctly on above Section Plat

Lincoln County, Sec. 17 Twp. 13 Rge. (E) 10 (W)
Location as "NE/CNW%SW%" or footage from lines NW NW
Lease Owner Donald T. Ingling et al
Lease Name Meyer Well No. 1
Office Address 615 First National Bldg., Wichita, Kansas
Character of Well (completed as Oil, Gas or Dry Hole) Dry Hole
Date well completed September 11, 1963
Application for plugging filed September 11, 1963
Application for plugging approved September 11, 1963
Plugging commenced September 11, 1963
Plugging completed September 11, 1963
Reason for abandonment of well or producing formation dry

If a producing well is abandoned, date of last production 19
Was permission obtained from the Conservation Division or its agents before plugging was commenced? Yes

Name of Conservation Agent who supervised plugging of this well Cecil Jones
Producing formation _____ Depth to top _____ Bottom _____ Total Depth of Well 3763 Feet
Show depth and thickness of all water, oil and gas formations.

OIL, GAS OR WATER RECORDS

CASING RECORD

FORMATION	CONTENT	FROM	TO	SIZE	PUT IN	PULLED OUT
				8 5/8"	303	None

Describe in detail the manner in which the well was plugged, indicating where the mud fluid was placed and the method or methods used in introducing it into the hole. If cement or other plugs were used, state the character of same and depth placed, from _____ feet to _____ feet for each plug set.

Leave five stands drill pipe in derrick - run Halco plug at 300 feet then one-half sack hulls, 20 sacks cement and mud then a plug and hulls^{at 30 feet} and 8 sacks cement and mud to surface - 2 sacks cement in rat hole

RECEIVED
STATE CORPORATION COMMISSION

SEP 16 1963
09-16-1963
CONSERVATION DIVISION
Wichita, Kansas

(If additional description is necessary, use BACK of this sheet)

Name of Plugging Contractor Donald T. Ingling
Address 615 First National Bldg., Wichita, Kansas

STATE OF KANSAS, COUNTY OF SEDGWICK, ss.
D. T. Ingling (owner) or (owner or operator) of the above-described well, being first duly sworn on oath, says: That I have knowledge of the facts, statements, and matters herein contained and the log of the above-described well as filed and that the same are true and correct. So help me God.

(Signature) D. T. Ingling
615 First National Bldg., Wichita, Kans
(Address)

SUBSCRIBED AND SWORN to before me this 13th day of September, 1963

My commission expires Feb. 27, 1964

Notary Public.

INVOICED

DATE 9/16/63
INV. NO. 7743-W

WELL LOG - MEYER NO. 1

Donald T. Ingling et al, Lease Owner

Section 17-13-10W

Donald T. Ingling, Contractor

Location: NW NW

Commenced: 8-27-63

County: Lincoln

Completed: 9-11-63

Production: Dry

Total Depth: 3763

Elevation: 1737 RB

Casing: 8 5/8" 303' (150 sacks cement)

Figures below indicate bottom formation

70	clay and shale	3230	lime
460	shale and shells	3290	lime and shale
655	shale	3367	Conglomerate
675	Anhydrite	3383	lime
800	shale and shells	3422	lime
1200	shale and shells	3456	Mississippi
1430	shale and lime streaks	3500	shale
1455	sandy lime	3540	lime
1580	lime and shale	3575	lime
1660	lime	3600	lime
1745	lime	3640	lime and shale
1865	lime	3670	lime
1970	lime	3685	lime and shale
2070	lime	3730	lime and shale
2170	lime and shale	3757	Simpson
2290	lime and shale	3763	Arbuckle
2405	lime and shale	3763	Total Depth
2510	shale and shells		
2605	shale and lime		
2680	lime and shale		
2755	lime and shale		
2840	lime and shale		
2920	lime and shale		
2965	lime		
3015	lime		
3070	lime		
3115	lime		
3180	lime		

RECEIVED
STATE CORPORATION COMMISSION

SEP 16 1963
09-16-1963
CONSERVATION DIVISION
Wichita, Kansas

I certify this is a true and correct copy of the above mentioned well.

STATE OF KANSAS)
) ss.
SEDGWICK COUNTY)

D. T. Ingling

Subscribed and sworn to before me, a Notary Public, in said county and state.

ME Black
Notary Public

My commission expires: Feb. 27, 1964