

15-097-20101-00-00


Form CP-4

STATE OF KANSAS
STATE CORPORATION COMMISSION

Give All Information Completely
Make Required Affidavit
Mail or Deliver Report to:
Conservation Division
State Corporation Commission
212 No. Market
Wichita, Kansas

WELL PLUGGING RECORD

NORTH

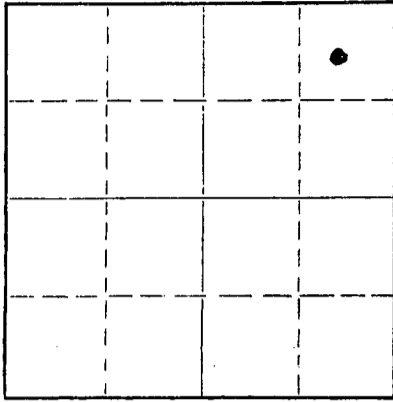

Locate well correctly on above
Section Plat

Kiowa County, Sec. 24 Twp. 28S Rge. (E) 18 (W)

Location as "NE/CNW*SW*" or footage from lines C NE NE
Lease Owner Roger Cale
Lease Name Hardy Well No. 1
Office Address 1750 Elpyco - Wichita, Kansas 67218
Character of Well (completed as Oil, Gas or Dry Hole) Dry hole
Date well completed Aug. 10, 19 70
Application for plugging filed Aug. 10, 19 70
Application for plugging approved Aug. 10, 19 70
Plugging commenced Aug. 10, 19 70
Plugging completed Aug. 10, 19 70
Reason for abandonment of well or producing formation

If a producing well is abandoned, date of last production 19
Was permission obtained from the Conservation Division or its agents before plugging was commenced? Yes

Name of Conservation Agent who supervised plugging of this well Russell Biberstein
Producing formation Depth to top Bottom Total Depth of Well 4875 Feet
Show depth and thickness of all water, oil and gas formations.

OIL, GAS OR WATER RECORDS

CASING RECORD

FORMATION	CONTENT	FROM	TO	SIZE	PUT IN	PULLED OUT
		0	326	8-5/8	326	None

Describe in detail the manner in which the well was plugged, indicating where the mud fluid was placed and the method or methods used in introducing it into the hole. If cement or other plugs were used, state the character of same and depth placed, from feet to feet for each plug set.

Filled hole with heavy mud to 550 feet. Set first plug @ 550 feet w/75 sacks cement.
Filled hole with heavy mud to 300 feet. Set second plug @ 300 feet w/35 sacks cement.
Filled hole with heavy mud to 40 feet. Set third plug @ 40 feet w/10 sacks cement.
Bridged rat hole with 1 sack cement. Cement pumped with Globe Oilwell Cementing truck.

RECEIVED
STATE CORPORATION COMMISSION
AUG 18 1970
CONSERVATION DIVISION
Wichita, Kansas

(If additional description is necessary, use BACK of this sheet)
Name of Plugging Contractor Gabbert-Jones, Inc.
Address 830 Sutton Place - Wichita, Kansas 67202

STATE OF Kansas, COUNTY OF Sedgwick, ss.
J. W. Gabbert (employee of owner) or (owner or operator) of the above-described well, being first duly sworn on oath, says: That I have knowledge of the facts, statements, and matters herein contained and the log of the above-described well as filed and that the same are true and correct. So help me God.

(Signature) J. W. Gabbert
830 Sutton Place - Wichita, Kansas 67202
(Address)

SUBSCRIBED AND SWORN to before me this 17 day of August, 19 70



Feb. 1, 1972
Barbara J. Layton
Notary Public.

GABBERT-JONES, INC.
WICHITA, KANSAS
DRILLERS' WELL LOG

HARDY #1
C NE NE Section 24-28S-18W
Kiowa County, Kansas

Commenced: July 27, 1970
Completed: August 10, 1970

RECEIVED
STATE CORPORATION COMMISSION
AUG 18 1970
CONSERVATION DIVISION
Wichita, Kansas

OPERATOR - Roger Cale

DEPTH		FORMATION	REMARKS
From	To		
0	140	Surface clay and sand	
140	680	Shale and shells	Ran 9 joints 8-5/8" casing, set @ 326' w/200 sacks cement.
680	999	Red bed	
999	1119	Red bed and shale	
1119	1131	Anhydrite	
1131	1217	Red bed and shale	
1217	1600	Shale and shells	
1600	1850	Shale and lime	
1850	2265	Shale and shells	
2265	4075	Lime and shale	
4075	4135	Shale	
4135	4230	Shale and lime	
4230	4525	Lime	
4525	4586	Lime and shale	
4586	4830	Lime	
4830	4845	Lime and chert	
4845	4875	Lime	
4875		TD	Dry and abandoned.

I, JAMES S. SUTTON, II, certify this is a correct copy of the Drillers' Log for the well drilled in the C NE NE Section 24-28S-18W, Kiowa County, Kansas, to the best of my knowledge and belief.

James S. Sutton II

 JAMES S. SUTTON, II

STATE OF KANSAS)
) SS
 COUNTY OF SEDGWICK)

Before me, the undersigned, a Notary Public within and for said County and State, on this 11 day of August, 1970, personally appeared James S. Sutton, II to me personally known to be the identical person who executed the within and foregoing instrument and acknowledged to me that he executed the same as his free and voluntary act and deed for the uses and purposes therein set forth.

IN WITNESS WHEREOF, I have hereunto set my hand and official seal the day and year last above written.

My Commission Expires Feb. 1, 1972.

Barbara J. Layton

 Barbara J. Layton, Notary Public

