


15-097-20216-00-00

STATE OF KANSAS
STATE CORPORATION COMMISSION

Form CP-4

Give All Information Completely
Make Required Affidavit
Mail or Deliver Report to:
Conservation Division
State Corporation Commission
P. O. Box 17027
Wichita, Kansas 67217
NORTH

WELL PLUGGING RECORD

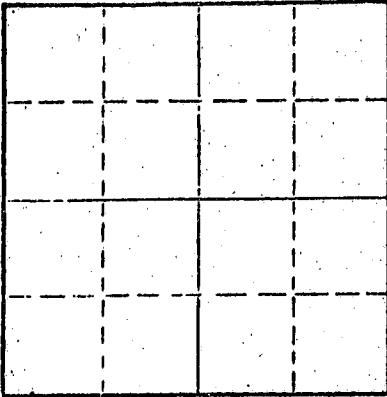

Locate well correctly on above
Section Plat

Kiowa County, Sec. 24 Twp 28 Rge. (E) 18W (W)
Location as "NE/CNW/SW" or footage from lines C SE SW
Lease Owner W. B. Osborn, Jr.
Lease Name Keller Well No. 1
Office Address P. O. Box 6767, San Antonio, Texas 78209
Character of Well (completed as Oil, Gas or Dry Hole) Dry Hole
Date well completed 4-18 19 74
Application for plugging filed 4-18 19 74
Application for plugging approved 4-18 19 74
Plugging commenced 4-18 19 74
Plugging completed 4-18 19 74
Reason for abandonment of well or producing formation No commercial quantities of oil or gas encountered.
If a producing well is abandoned, date of last production 19
Was permission obtained from the Conservation Division or its agents before plugging was commenced? Yes

Name of Conservation Agent who supervised plugging of this well G. R. Boberstein
Producing formation Depth to top Bottom Total Depth of Well 4886 Feet
Show depth and thickness of all water, oil and gas formations.

OIL, GAS OR WATER RECORDS

CASING RECORD

FORMATION	CONTENT	FROM	TO	SIZE	PUT IN	PULLED OUT
Surface Hole	Water	Surface	350	8-5/8"	342'	None

Describe in detail the manner in which the well was plugged, indicating where the mud fluid was placed and the method or methods used in introducing it into the hole. If cement or other plugs were used, state the character of same and depth placed, from feet to feet for each plug set.

Fluid to 325', plug, 40 sx cement;
Fluid to 40', plug, 1/2 sx hulls, 15 sx cement;
Two sacks cement in rat hole.

RECEIVED
STATE CORPORATION COMMISSION
APR 25 1974
CONSERVATION DIVISION
Wichita, Kansas

(If additional description is necessary, use BACK of this sheet)
Name of Plugging Contractor D N B DRILLING, INC.
Address 701 First Nat'l Bldg., Wichita, Kansas 67202

STATE OF KANSAS, COUNTY OF ss.
JAMES L. DONELSON (employee of owner) or (owner or operator) of the above-described well, being first duly sworn on oath, says: That I have knowledge of the facts, statements, and matters herein contained and the log of the above-described well as filed and that the same are true and correct. So help me God.

(Signature) James L. Donelson
701 First Nat'l Bldg., Wichita, Kansas
(Address)

SUBSCRIBED AND SWORN TO before me this 24th day of April, 19 74

My commission expires August 25, 1976

Ella Priess
Ella Priess Notary Public.
STATE NOTARY PUBLIC
Sedgwick County, Kansas
My Com. Expires Aug. 25, 1976

DRILLERS' LOG

W. B. OSBORN, JR.
No. 1 Keller
C SE SW, Sec. 24-28-18W
Kiowa County, Kansas

Elevation: 2225 K.B.

Commenced: 4-5-74
Completed: 4-18-74

Surface: 342' of 8-5/8"
cemented w/300 sx common
cement, 2% Gal, 3% cc.
4-5-74

FORMATION

DEPTH

Surface Hole	0 - 350
Shale	350 - 527
Blaine Anhydrite	527 - 542
Shale & Sand	542 - 800
Shale	800 - 1137
Stone Corral Anhy.	1137 - 1158
Shale	1158 - 1900
Shale & Lime	1900 - 2715
Lime & Shale	2715 - 4073
Lime	4073 - 4886 T.D.

RECEIVED
STATE CORPORATION COMMISSION
APR 25 1974
CONSERVATION DIVISION
Wichita, Kansas

I do hereby certify that the foregoing statements are true and correct to the best of my knowledge and belief.

D N B DRILLING, INC.

James L. Donelson
JAMES L. DONELSON

STATE OF KANSAS: ss:

Subscribed and sworn to before me, the undersigned, a Notary Public in and for said state, this 24th day of April, 1974.

My Commission Expires:
August 25, 1976

Ella Priess
Ella Priess, Notary Public

Ella Priess
STATE NOTARY PUBLIC
Sedgwick County, Kansas
My Com. Expires Aug. 25, 1976