

CARD MUST BE TYPED

# NOTICE OF INTENTION TO DRILL

CARD MUST BE SIGNED

(see rules on reverse side)

*Collection*

Starting Date: MARCH 11, 1987  
month day year

API Number 15-185-22,42301-00-1187

OPERATOR: License # 9069  
Name GENERAL OIL COMPANY, INC.  
Address 1540 N. BROADWAY, SUITE 203  
City/State/Zip WICHITA, KS 67214  
Contact Person JOHN BANNISTER  
Phone (316) 263-8588

*NWSE*  East  
 West  
SURFACE (location) BOTTOM HOLE  
1980 2640 Ft North from Southeast Corner of Section  
\* 1980 2640 Ft West from Southeast Corner of Section  
(Note: Locate well on Section Plat on reverse side)

CONTRACTOR: License # 5122  
Name WOODMAN-IANNITTI DRILLING CO.  
City/State P.O. BOX 308 GREAT BEND, KS 67530

Nearest lease or unit boundary line 2640 feet.  
County STAFFORD

Lease Name WHOOPIING CRANE Well# 1-A

Well Drilled For: Well Class: Type Equipment:  
 Oil  Swd  Infield  Mud Rotary  
 Gas  Inj  Pool Ext.  Air Rotary  
 OWWO  Expl  Wildcat  Cable

Domestic well within 330 feet:  yes  no  
Municipal well within one mile:  yes  no

If OWWO: old well info as follows:  
Operator .....  
Well Name .....  
Comp Date ..... Old Total Depth .....  
Projected Total Depth 3600 feet  
Projected Formation at TD ARBUCKLE  
Expected Producing Formations .....

Depth to Bottom of fresh water APROX. 100 feet  
Lowest usable water formation .....  
Depth to Bottom of usable water 200 feet  
Surface pipe by Alternate: 1  2   
Surface pipe to be set 250 feet  
Conductor pipe if any required ..... feet  
Ground surface elevation 1743 feet MSI.  
This Authorization Expires 9-5-87

Approved By [Signature] 3-5-87  
*WAS. 3300 FEL*


I certify that we will comply with K.S.A. 55-101, et seq., plus eventually plugging hole to K.C.C. specifications.

Date MARCH 10, 1987 Signature of Operator or Agent [Signature] Title AGENT #3

Must be filed with the K.C.C. five (5) days prior to commencing well  
This card void if drilling not started within six (6) months of date received by K.C.C.

**Important procedures to follow :**

**A Regular Section of Land**  
**1 Mile = 5,280 Ft.**

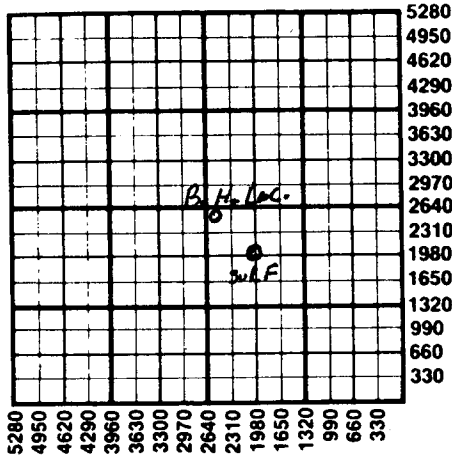

1. Notify District office before setting surface casing.
2. Set surface casing by circulating cement to the top.
3. File completion forms ACO-1 with K.C.C. within 90 days of well completion, following instructions on ACO-1, side 1, and including copies of wireline logs.
4. Notify District office 48 hours prior to old well workover or re-entry.
5. Prior to plugging, prepare a plugging plan, then obtain agreement from the appropriate district office for an approved plugging plan.
6. Submit plugging report (CP-4) to K.C.C. after plugging is completed.
7. Obtain an approved injection docket number before disposing of salt water.
8. Notify K.C.C. within 10 days when injection commences or terminates.
9. If an alternate 2 completion, cement in the production pipe from below any usable water to surface within 120 days of spud date.

**State Corporation Commission of Kansas**  
**Conservation Division**  
**200 Colorado Derby Building**  
**Wichita, Kansas 67202**  
**(316) 263-3238**