


WELL PLUGGING RECORD

Give All Information Completely
Make Required Affidavit
Mail or Deliver Report to:
Conservation Division
State Corporation Commission
800 Bitting Building
Wichita, Kansas

NORTH

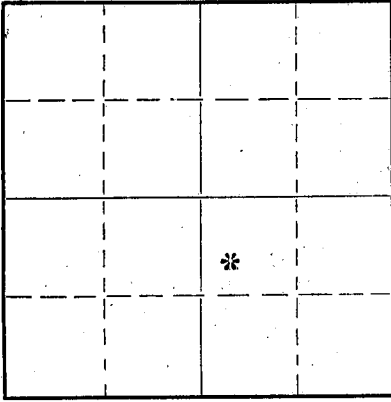

Locate well correctly on above Section Plat

Ellis County, Sec. 22 Twp. 11 Rge. 16 (E) (W)
Location as "NE/CNW $\frac{1}{4}$ SW $\frac{1}{4}$ " or footage from lines SW $\frac{1}{4}$ NE $\frac{1}{4}$ SW $\frac{1}{4}$
Lease Owner Great Lakes Carbon Corporation
Lease Name Don Chrisler Well No. 1
Office Address 501 Petroleum Bldg., Wichita, Kansas
Character of Well (completed as Oil, Gas or Dry Hole) Dry Hole
Date well completed March 14, 1950
Application for plugging filed March 14, 1950
Application for plugging approved March 14, 1950
Plugging commenced March 14, 1950
Plugging completed March 14, 1950
Reason for abandonment of well or producing formation Dry Hole

If a producing well is abandoned, date of last production 19
Was permission obtained from the Conservation Division or its agents before plugging was commenced? Yes

Name of Conservation Agent who supervised plugging of this well Eldon Petty
Producing formation none Depth to top Bottom Total Depth of Well 3105 Feet
Show depth and thickness of all water, oil and gas formations.

OIL, GAS OR WATER RECORDS

CASING RECORD

Formation	Content	From	To	Size	Put In	Pulled Out
	None					

Describe in detail the manner in which the well was plugged, indicating where the mud fluid was placed and the method or methods used in introducing it into the hole. If cement or other plugs were used, state the character of same and depth placed, from feet to feet for each plug set.

Heavy mud 3105' - 250'
Plug 250' - 248'
15 Sacks cement 248' - 218'
Heavy mud 218' - 35'
10 Sacks cement 35' - 6' cellar

(If additional description is necessary, use BACK of this sheet)

Correspondence regarding this well should be addressed to Great Lakes Carbon Corporation
Address 501 Petroleum Bldg., Wichita 2, Kansas

STATE OF KANSAS, COUNTY OF SEDGWICK, ss.


I, D. H. Sholtus, Prod. Supt. (employee of owner) or (SUPERVISOR) of the above-described well, being first duly sworn on oath, says: That I have knowledge of the facts, statements, and matters herein contained and the log of the above-described well as filed and that the same are true and correct. So help me God.

(Signature) D. H. Sholtus, Dist. Prod. Supt.
501 Pet Building, Wichita, Kans.
(Address)

SUBSCRIBED AND SWORN TO before me this 21st day of March, 1950.


Jack F. Shekaton
Notary Public.

My commission expires Jan. 22, 1951

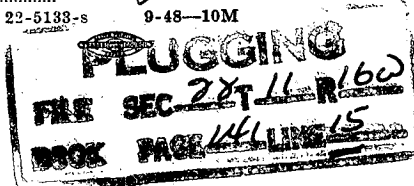

MAR 28 1950

Recd 3-23-50

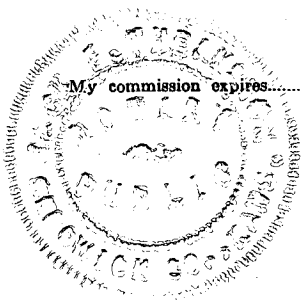

GABBERT - JONES DRILLING COMPANY
DRILLERS WELL LOG

Don
Great Lakes Carbon Corporation - Chrisler #1
Commenced - 2-20-50
Completed - 3-5 -50

Depth		Formation	Remarks
From	To		
0	40	Surface Clay & Sand	
40	150	Sand & Shale	
150	300	Shale & Shells	
300	375	Sandy Shale	
375	630	Sand Shale & Shells	
630	650	Shale	
650	700	Sand	
700	725	Red Bed	
725	820	Red Bed & Sand	
820	985	Red Bed	
985	995	Anhydrite	
995	1019	Anhydrite	Run 32 Jts of 8 5/8"
1019	1195	Shale	surface, cemented w/500
1195	1295	Shale & Red Bed	sacks cement.
1295	1410	Shale & Shells	
1410	1525	Salt & Sandy Shale	
1525	1795	Salt, Shale & Shells	
1795	1885	Shale & Shells	
1885	1990	Lime	
1990	2045	Lime	
2045	2110	Lime	
2110	2210	Lime	
2210	2305	Lime & Shale	
2305	2410	Lime & Shale	
2410	2545	Lime & Shale	
2545	2625	Lime & Shale	
2625	2675	Lime & Shale	
2675	2750	Lime & Shale	
2750	2795	Lime	
2795	2830	Lime	
2830	2895	Lime	
2895	2935	Lime & Shale	
2935	2946	Lime	
2946	2950	Lime	
2950	3015	Lime	
3015	3069	Lime	
3069	3105	Lime	
3105	TD		Run Plugged dry hole w/20 sks. cement.

Executed, This 7th day of March, 1950

C. L. Gabbert

STATE OF KANSAS)
COUNTY OF BARTON) ss

ACKNOWLEDGMENT FOR INDIVIDUAL

Before me, the undersigned, a Notary Public, within and for said county and State, on this 7th day of March, 1950, personally appeared C. L. Gabbert to me personally known to be the identical person who executed the within and foregoing instrument and acknowledged to me that he executed the same as his free and voluntary act and deed for the uses and purposes therein set forth.

IN WITNESS WHEREOF, I have hereunto set my hand and official seal the day and year last above written.

My commission expires April 16, 1951

Albert J. Kuchman

NOTARY PUBLIC



PLUGGING
ONE SEC 27T 11 R (160)
BOOK PAGE 141 LINE 15