

For KCC Use: 9-18-2010
Effective Date: _____
District # 2
SGA? Yes No

KANSAS CORPORATION COMMISSION
OIL & GAS CONSERVATION DIVISION

Form C-1
March 2010
Form must be Typed
Form must be Signed
All blanks must be Filled

NOTICE OF INTENT TO DRILL

Must be approved by KCC five (5) days prior to commencing well
Form KSONA-1, Certification of Compliance with the Kansas Surface Owner Notification Act, MUST be submitted with this form.

Expected Spud Date: September 20, 2010
month day year

OPERATOR: License# 31514
Name: Thoroughbred Associates, LLC
Address 1: 8100 E. 22nd St. No.
Address 2: Bldg. 600, Suite F
City: Wichita State: KS Zip: 67226
Contact Person: Robert C. Patton, Managing Partner
Phone: 316 685 1512

CONTRACTOR: License# 5822
Name: Val Energy, Inc.

Well Drilled For: Oil Gas Seismic; # of Holes _____
 Enh Rec Storage Disposal Other: _____
Well Class: Infield Pool Ext. Wildcat Other: _____
Type Equipment: Mud Rotary Air Rotary Cable
 If OWWO: old well information as follows: _____
Operator: _____
Well Name: _____
Original Completion Date: _____ Original Total Depth: _____

Directional, Deviated or Horizontal wellbore? Yes No
If Yes, true vertical depth: RECEIVED
Bottom Hole Location: _____
KCC DKT #: SEP 10 2010

Spot Description: _____
SW - NW - NE - Sec. 14 Twp. 30 S. R. 2 E W
(a/a/a/a) 990 feet from N / S Line of Section
2,310 feet from E / W Line of Section
Is SECTION: Regular Irregular?

(Note: Locate well on the Section Plat on reverse side)
County: Sumner
Lease Name: Sparr Well #: 1
Field Name: _____
Is this a Prorated / Spaced Field? Yes No
Target Formation(s): Lansing-KC
Nearest Lease or unit boundary line (in footage): 330'
Ground Surface Elevation: 1326.1' feet MSL
Water well within one-quarter mile: Yes No
Public water supply well within one mile: Yes No
Depth to bottom of fresh water: 100'
Depth to bottom of usable water: 230'
Surface Pipe by Alternate: I II
Length of Surface Pipe Planned to be set: 300'
Length of Conductor Pipe (if any): N/A
Projected Total Depth: 3800'
Formation at Total Depth: Mississippian
Water Source for Drilling Operations:
 Well Farm Pond Other: _____
DWR Permit #: _____ (Note: Apply for Permit with DWR)
Will Cores be taken? Yes No
If Yes, proposed zone: _____

KCC WICHITA

AFFIDAVIT

The undersigned hereby affirms that the drilling, completion and eventual plugging of this well will comply with K.S.A. 55 et. seq.

It is agreed that the following minimum requirements will be met:

1. Notify the appropriate district office **prior** to spudding of well;
2. A copy of the approved notice of intent to drill **shall be posted** on each drilling rig;
3. The minimum amount of surface pipe as specified below **shall be set** by circulating cement to the top; in all cases surface pipe **shall be set** through all unconsolidated materials plus a minimum of 20 feet into the underlying formation.
4. If the well is dry hole, an agreement between the operator and the district office on plug length and placement is necessary **prior to plugging**;
5. The appropriate district office will be notified before well is either plugged or production casing is cemented in;
6. If an ALTERNATE II COMPLETION, production pipe shall be cemented from below any usable water to surface within **120 DAYS** of spud date. Or pursuant to Appendix "B" - Eastern Kansas surface casing order #133,891-C, which applies to the KCC District 3 area, alternate II cementing must be completed within 30 days of the spud date or the well shall be plugged. **In all cases, NOTIFY district office** prior to any cementing.

I hereby certify that the statements made herein are true and to the best of my knowledge and belief.

Date: 09-10-10 Signature of Operator or Agent: Robert Patton Title: Managing Partner

For KCC Use ONLY
API # 15 - 191-22586-00-00
Conductor pipe required None feet
Minimum surface pipe required 250 feet per ALT. I II
Approved by: SB 9-13-2010
This authorization expires: 9-13-2011
(This authorization void if drilling not started within 12 months of approval date.)
Spud date: _____ Agent: _____

Remember to:

- File Certification of Compliance with the Kansas Surface Owner Notification Act (KSONA-1) with Intent to Drill;
- File Drill Pit Application (form CDP-1) with Intent to Drill;
- File Completion Form ACO-1 within 120 days of spud date;
- File acreage attribution plat according to field proration orders;
- Notify appropriate district office 48 hours prior to workover or re-entry;
- Submit plugging report (CP-4) after plugging is completed (within 60 days);
- Obtain written approval before disposing or injecting salt water.
- If well will not be drilled or permit has expired (See: authorized expiration date) please check the box below and return to the address below.

Well will not be drilled or Permit Expired Date: _____
Signature of Operator or Agent: _____

Mail to: KCC - Conservation Division,
130 S. Market - Room 2078, Wichita, Kansas 67202

14
30
2
 E
 W

For KCC Use ONLY
 API # 15 - 191-22586-00-00

IN ALL CASES PLOT THE INTENDED WELL ON THE PLAT BELOW

In all cases, please fully complete this side of the form. Include items 1 through 5 at the bottom of this page.

Operator: Thoroughbred Associates, LLC
 Lease: Sparr
 Well Number: 1
 Field: _____

Location of Well: County: Sumner
990 feet from N / S Line of Section
2,310 feet from E / W Line of Section
 Sec. 14 Twp. 30 S. R. 2 E W

Number of Acres attributable to well: 160
 QTR/QTR/QTR/QTR of acreage: SW - NW - NE - _____

Is Section: Regular or Irregular

If Section is Irregular, locate well from nearest corner boundary.

Section corner used: NE NW SE SW


RECEIVED

SEP 10 2010


KCC WICHITA

PLAT

Show location of the well. Show footage to the nearest lease or unit boundary line. Show the predicted locations of lease roads, tank batteries, pipelines and electrical lines, as required by the Kansas Surface Owner Notice Act (House Bill 2032). You may attach a separate plat if desired.

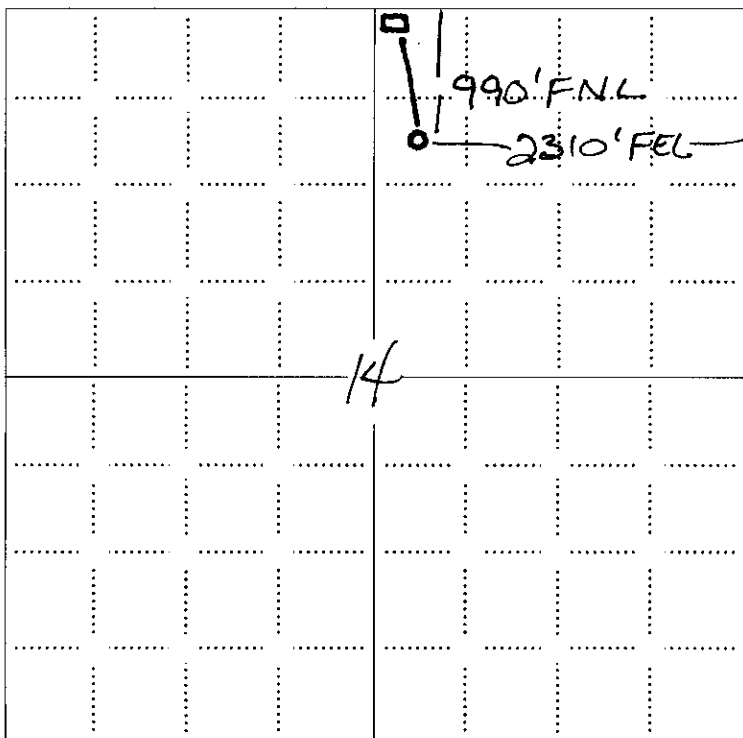

- LEGEND**
- Well Location
 - Tank Battery Location
 - Pipeline Location
 - Electric Line Location
 - Lease Road Location

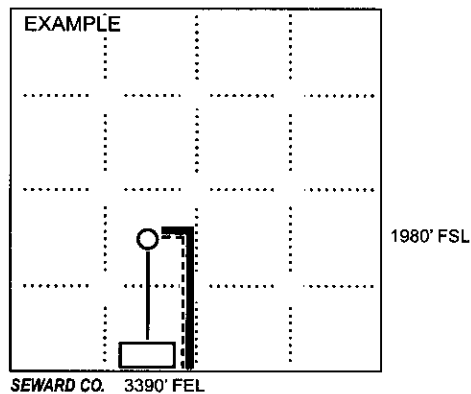

NOTE: In all cases locate the spot of the proposed drilling locaton.

In plotting the proposed location of the well, you must show:

1. The manner in which you are using the depicted plat by identifying section lines, i.e. 1 section, 1 section with 8 surrounding sections, 4 sections, etc.
2. The distance of the proposed drilling location from the south / north and east / west outside section lines.
3. The distance to the nearest lease or unit boundary line (in footage).
4. If proposed location is located within a prorated or spaced field a certificate of acreage attribution plat must be attached: (CO-7 for oil wells; CG-8 for gas wells).
5. The predicted locations of lease roads, tank batteries, pipelines, and electrical lines.

RECEIVED
SEP 10 2010
KCC WICHITA

KANSAS CORPORATION COMMISSION
OIL & GAS CONSERVATION DIVISION

Form KSONA-1
July 2010
Form Must Be Typed
Form must be Signed
All blanks must be Filled

**CERTIFICATION OF COMPLIANCE WITH THE
KANSAS SURFACE OWNER NOTIFICATION ACT**

This form must be submitted with all Forms C-1 (Notice of Intent to Drill); CB-1 (Cathodic Protection Borehole Intent); T-1 (Request for Change of Operator Transfer of Injection or Surface Pit Permit); and CP-1 (Well Plugging Application). Any such form submitted without an accompanying Form KSONA-1 will be returned.

Select the corresponding form being filed: C-1 (Intent) CB-1 (Cathodic Protection Borehole Intent) T-1 (Transfer) CP-1 (Plugging Application)

OPERATOR: License # 31514
Name: Thoroughbred Associates, LLC
Address 1: 8100 E. 22nd St. No.
Address 2: Bldg. 600, Suite F
City: Wichita State: KS Zip: 67226 + _____
Contact Person: Robert C. Patton
Phone: (316) 685-1512 Fax: (316) 685-4821
Email Address: karri@lipizzancompanies.com

Well Location:
SW NW NE Sec. 14 Twp. 30 S. R. 2 East West
County: Sumner
Lease Name: Sparr Well #: 1

If filing a Form T-1 for multiple wells on a lease, enter the legal description of the lease below:

Surface Owner Information:

Name: June Sparr
Address 1: 1275 N. Perth Rd
Address 2: _____
City: Clearwater State: KS Zip: 67026 + _____

When filing a Form T-1 involving multiple surface owners, attach an additional sheet listing all of the information to the left for each surface owner. Surface owner information can be found in the records of the register of deeds for the county, and in the real estate property tax records of the county treasurer.

If this form is being submitted with a Form C-1 (Intent) or CB-1 (Cathodic Protection Borehole Intent), you must supply the surface owners and the KCC with a plat showing the predicted locations of lease roads, tank batteries, pipelines, and electrical lines. The locations shown on the plat are preliminary non-binding estimates. The locations may be entered on the Form C-1 plat, Form CB-1 plat, or a separate plat may be submitted.

Select one of the following:

- I certify that, pursuant to the Kansas Surface Owner Notice Act (House Bill 2032), I have provided the following to the surface owner(s) of the land upon which the subject well is or will be located: 1) a copy of the Form C-1, Form CB-1, Form T-1, or Form CP-1 that I am filing in connection with this form; 2) if the form being filed is a Form C-1 or Form CB-1, the plat(s) required by this form; and 3) my operator name, address, phone number, fax, and email address.
- I have not provided this information to the surface owner(s). I acknowledge that, because I have not provided this information, the KCC will be required to send this information to the surface owner(s). To mitigate the additional cost of the KCC performing this task, I acknowledge that I am being charged a \$30.00 handling fee, payable to the KCC, which is enclosed with this form.

If choosing the second option, submit payment of the \$30.00 handling fee with this form. If the fee is not received with this form, the KSONA-1 form and the associated Form C-1, Form CB-1, Form T-1, or Form CP-1 will be returned.


I hereby certify that the statements made herein are true and correct to the best of my knowledge and belief.

Date: 09-10-10 Signature of Operator or Agent: Robert C. Patton Title: Managing Partner

15-191-22586-00-00


RECEIVED

SEP 10 2010

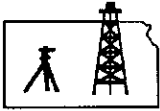

KCC WICHITA

Pro-Stake LLC
Oil Field & Construction Site Staking
P.O. Box 2324
Garden City, Kansas 67846
Office/Fax: (620) 276-6159
Cell: (620) 272-1499

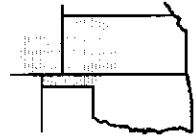

y090410-r
PLAT NO.

8943
INVOICE NO.

Thoroughbred Associates LLC

Sparr #1

OPERATOR

LEASE NAME

Sumner County, KS

990' FNL - 2310' FEL

COUNTY

14 30s 02w
Sec. Twp. Rng.

LOCATION SPOT

SCALE: 1" = 1000'

GR. ELEVATION: 1326.1'

DATE STAKED: Sept. 3rd, 2010

MEASURED BY: Luke R.

DRAWN BY: Gabe Q.


AUTHORIZED BY: Karri



Directions: From the SE side of Conway Springs, Ks at the intersection of Hwy 49 & W 90th Ave. - Now go 7 miles East on W 90th Ave - Now go 4 miles North on N Clearwater RD to the NW corner of section 14-30s-02w - Now go 0.5 mile East on 130th to ingress stake South into - Now go 990' South through worked milo - Now go 373' East through terraced worked milo into staked location.

Final ingress must be verified with land owner or Operator


This drawing does not constitute a monumented survey or a land survey plat This drawing is for construction purposes only

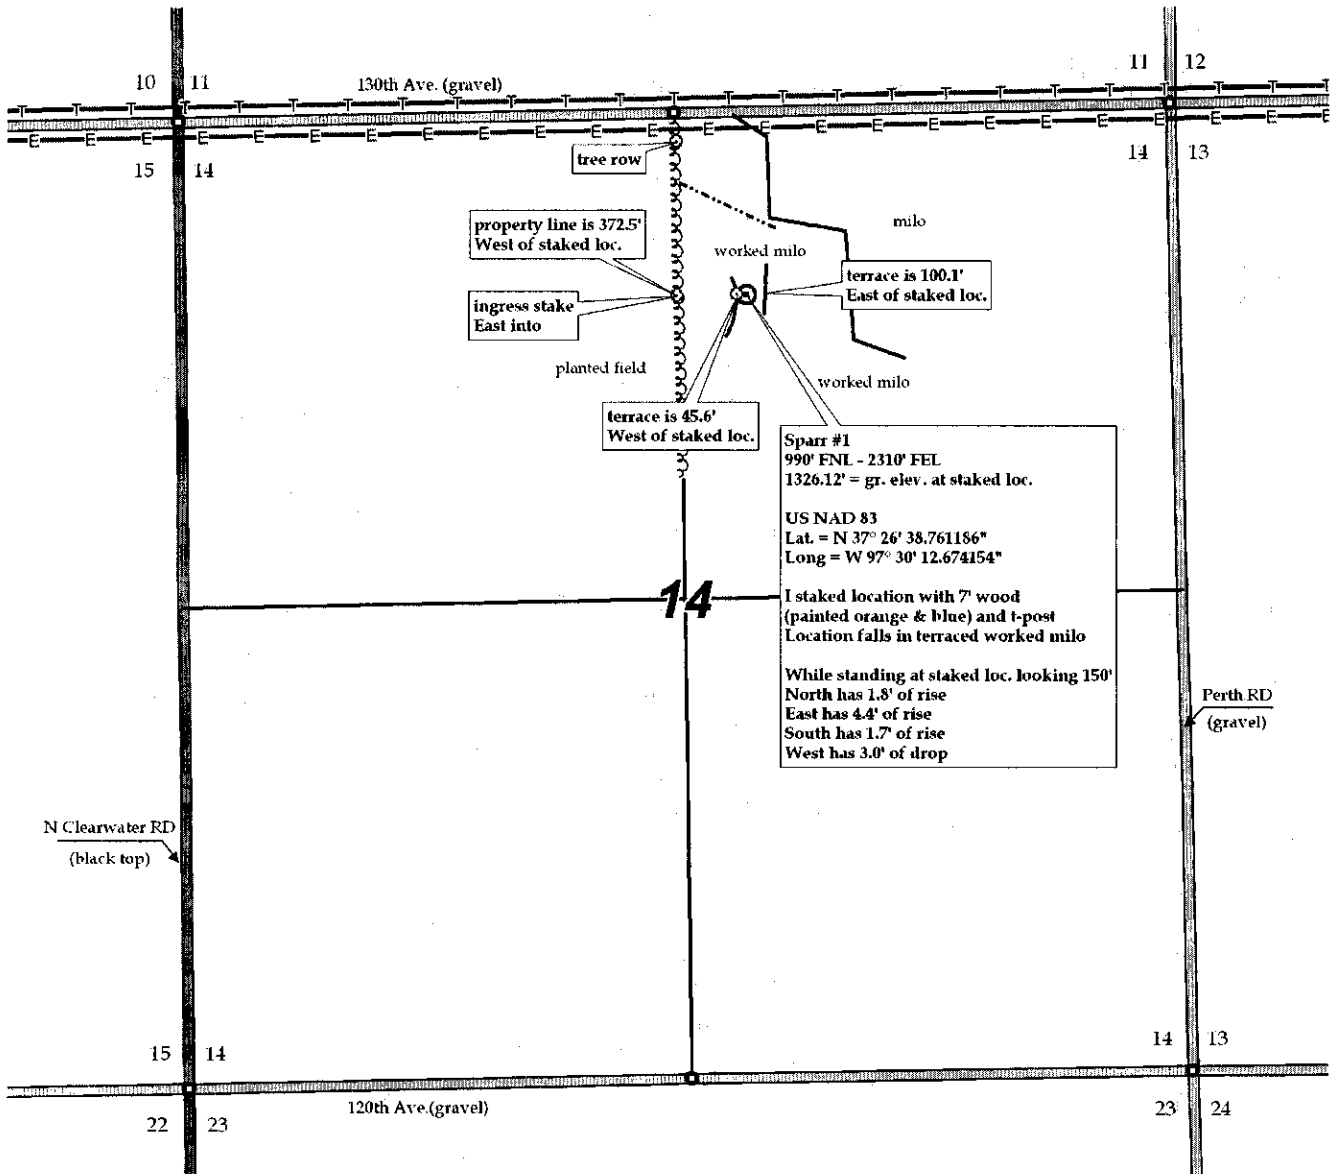

15-191-22586-00-00

RECEIVED

SEP 10 2010

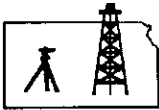


KCC WICHITA

y090410-r
PLAT NO.

Pro-Stake LLC
Oil Field & Construction Site Staking
P.O. Box 2324
Garden City, Kansas 67846
Office/Fax: (620) 276-6159
Cell: (620) 272-1499

8943
INVOICE NO.

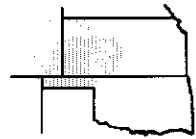

Thoroughbred Associates LLC

OPERATOR

Sumner County, KS

COUNTY

14 30s 02w
Sec. Twp. Rng.

Sparr #1

LEASE NAME

990' FNL - 2310' FEL

LOCATION SPOT

SCALE: 1" = 1000'
DATE STAKED: Sept. 3rd, 2010
MEASURED BY: Luke R.
DRAWN BY: Gabe Q.
AUTHORIZED BY: Karri




GR. ELEVATION: 1326.1'

Directions: From the SE side of Conway Springs, Ks at the intersection of Hwy 49 & W 90th Ave. - Now go 7 miles East on W 90th Ave - Now go 4 miles North on N Clearwater RD to the NW corner of section 14-30s-02w - Now go 0.5 mile East on 130th to ingress stake South into - Now go 990' South through worked milo - Now go 373' East through terraced worked milo into staked location.

Final ingress must be verified with land owner or Operator

This drawing does not constitute a monumented survey or a land survey plat This drawing is for construction purposes only

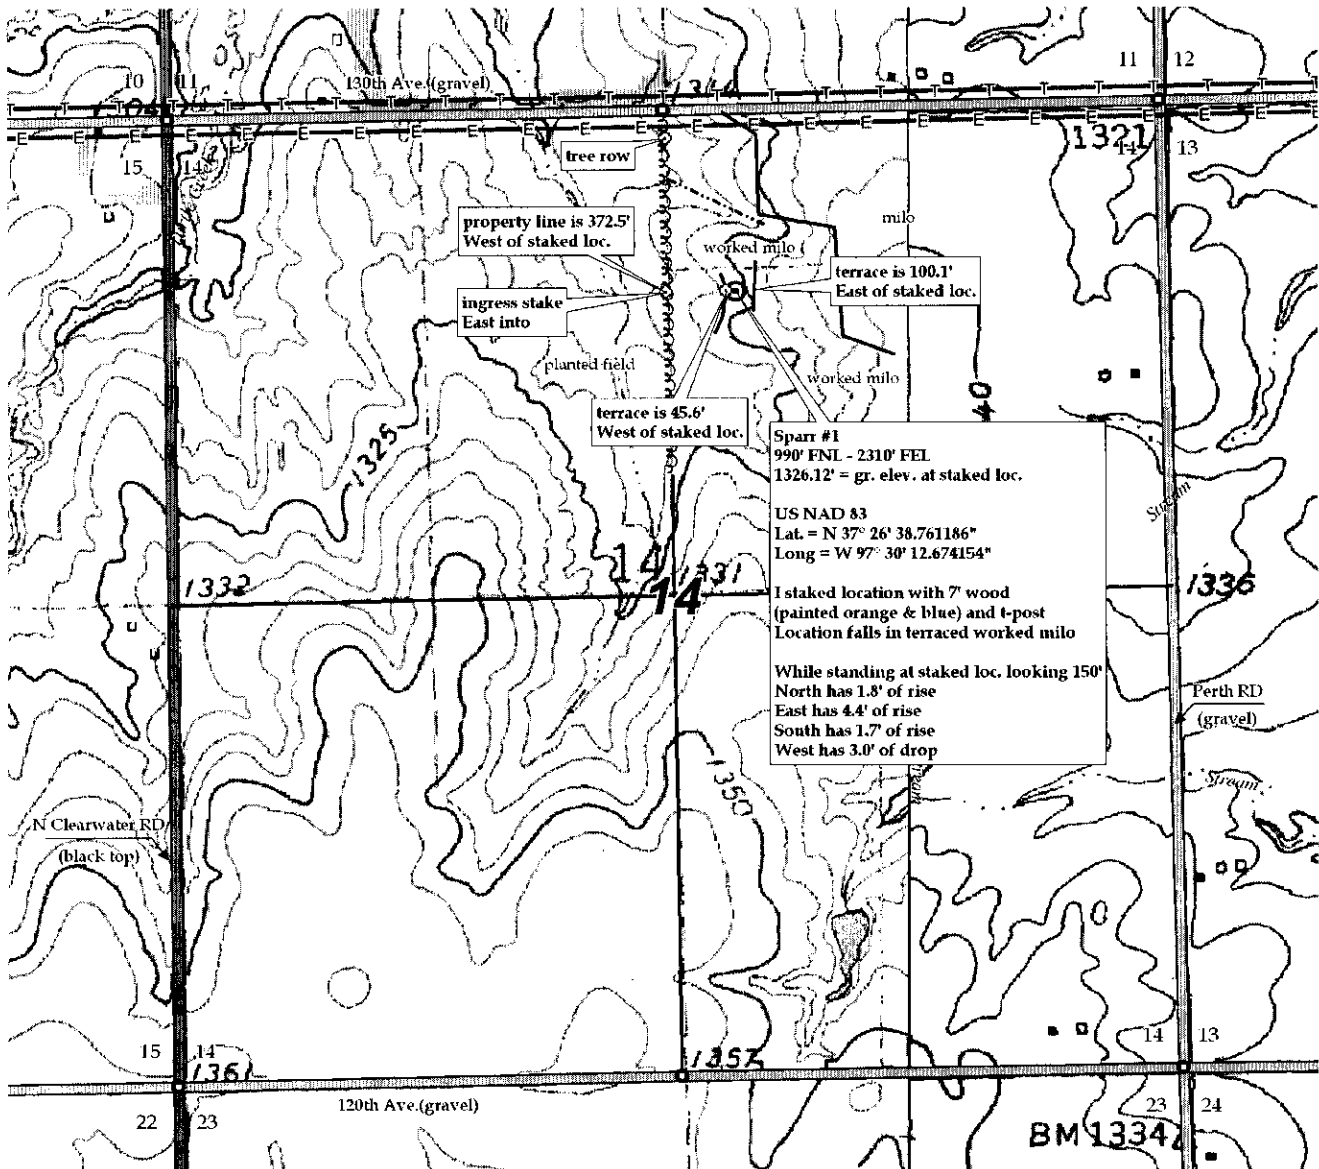

15-191-2258L-00-00

RECEIVED


SEP 10 2010

KCC WICHITA

KANSAS CORPORATION COMMISSION
OIL & GAS CONSERVATION DIVISION
APPLICATION FOR SURFACE PIT

Form CDP-1
May 2010
Form must be Typed

Submit in Duplicate

Operator Name: Thoroughbred Associates, LLC		License Number: 31514	
Operator Address: 8100 E. 22nd St. No.		Bldg. 600, Suite F Wichita KS 67226	
Contact Person: Robert C. Patton, Managing Partner		Phone Number: 316 685 1512	
Lease Name & Well No.: Sparr 1		Pit Location (QQQQ): NE	
Type of Pit: <input type="checkbox"/> Emergency Pit <input type="checkbox"/> Burn Pit <input type="checkbox"/> Settling Pit <input checked="" type="checkbox"/> Drilling Pit <input type="checkbox"/> Workover Pit <input type="checkbox"/> Haul-Off Pit <small>(If WP Supply API No. or Year Drilled)</small>		Pit is: <input checked="" type="checkbox"/> Proposed <input type="checkbox"/> Existing If Existing, date constructed: _____ Pit capacity: 6,800 (bbls)	
Is the pit located in a Sensitive Ground Water Area? <input type="checkbox"/> Yes <input checked="" type="checkbox"/> No		Chloride concentration: _____ mg/l <small>(For Emergency Pits and Settling Pits only)</small>	
Is the bottom below ground level? <input checked="" type="checkbox"/> Yes <input type="checkbox"/> No		Artificial Liner? <input checked="" type="checkbox"/> Yes <input type="checkbox"/> No	
How is the pit lined if a plastic liner is not used?		Pit dimensions (all but working pits): 80 Length (feet) 80 Width (feet) <input type="checkbox"/> N/A: Steel Pits Depth from ground level to deepest point: 3 (feet) <input type="checkbox"/> No Pit	
If the pit is lined give a brief description of the liner material, thickness and installation procedure.		Describe procedures for periodic maintenance and determining liner integrity, including any special monitoring.	
Distance to nearest water well within one-mile of pit: 2860 feet Depth of water well 90 feet		Depth to shallowest fresh water 15 feet. Source of information: <input type="checkbox"/> measured <input type="checkbox"/> well owner <input type="checkbox"/> electric log <input type="checkbox"/> KDWR	
Emergency, Settling and Burn Pits ONLY: Producing Formation: _____ Number of producing wells on lease: _____ Barrels of fluid produced daily: _____ Does the slope from the tank battery allow all spilled fluids to flow into the pit? <input type="checkbox"/> Yes <input type="checkbox"/> No		Drilling, Workover and Haul-Off Pits ONLY: Type of material utilized in drilling/workover: fresh Number of working pits to be utilized: 2 Abandonment procedure: evaporate and backfill Drill pits must be closed within 365 days of spud date.	
I hereby certify that the above statements are true and correct to the best of my knowledge and belief.			
09-10-10 Date		 Signature of Applicant or Agent	

15-191-22586-00-00

KCC OFFICE USE ONLY			
Date Received: 9-10-10		Permit Number: _____	
Permit Date: 9-10-10		Lease Inspection: <input type="checkbox"/> Yes <input checked="" type="checkbox"/> No	
<input type="checkbox"/> Liner		<input type="checkbox"/> Steel Pit <input type="checkbox"/> RFAC <input type="checkbox"/> RFAS	

Mail to: KCC - Conservation Division, 130 S. Market - Room 2078, Wichita, Kansas 67202