


Give All Information Completely
Make Required Affidavit
Mail or Deliver Report to:
Conservation Division
State Corporation Commission
211 No. Broadway
Wichita, Kansas

WELL PLUGGING RECORD

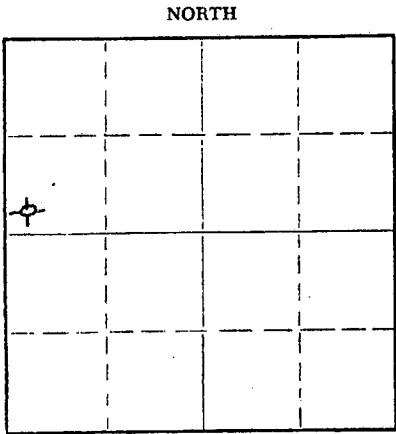

Locate well correctly on above Section Plat

Russell County. Sec. 32 Twp. 13S Rge. 13 (E) W (W)
Location as "NE/CNW/SW" or footage from lines SW/4 SW/4 NW/4
Lease Owner Birmingham-Bartlett Drilling Co.
Lease Name COADY Well No. 1
Office Address 300 Kaufman Bldg., Wichita 2, Kansas
Character of Well (completed as Oil, Gas or Dry Hole) Dry Hole
Date well completed October 7, 19 62
Application for plugging filed (Verbal) October 7, 19 62
Application for plugging approved (Verbal) October 7, 19 62
Plugging commenced October 7, 19 62
Plugging completed October 7, 19 62
Reason for abandonment of well or producing formation Dry Hole

If a producing well is abandoned, date of last production 19
Was permission obtained from the Conservation Division or its agents before plugging was commenced? Yes

Name of Conservation Agent who supervised plugging of this well Donald Truan
Producing formation _____ Depth to top _____ Bottom _____ Total Depth of Well 3370 Feet
Show depth and thickness of all water, oil and gas formations.

OIL, GAS OR WATER RECORDS

CASING RECORD

FORMATION	CONTENT	FROM	TO	SIZE	PUT IN	PULLED OUT
		0	192'	8-5/8"	192'	none

Describe in detail the manner in which the well was plugged, indicating where the mud fluid was placed and the method or methods used in introducing it into the hole. If cement or other plugs were used, state the character of same and depth placed, from _____ feet to _____ feet for each plug set.

Bottom plug set at 325' with 1/4 sack hulls and 20 sacks cement.
#2 plug set at 180' with 1/4 sack hulls and 20 sacks cement.
#3 plug set at 40' with 1/2 sack hulls and 10 sacks cement.

RECEIVED
STATE CORPORATION COMMISSION
OCT 10 1962
10-10-1962
CONSERVATION DIVISION
Wichita, Kansas

(If additional description is necessary, use BACK of this sheet)
Name of Plugging Contractor Birmingham-Bartlett Drilling Co.
Address 300 Kaufman Bldg., Wichita 2, Kansas

STATE OF KANSAS, COUNTY OF SEDGWICK
Richard Hindery, partner of Birmingham-Bartlett Drilling Co., owner, operator, & contractor
(employee of owner) or (owner or operator) of the above-described well, being first duly sworn on oath, says: That I have knowledge of the facts, statements, and matters herein contained and the log of the above-described well as filed and that the same are true and correct. So help me God. BIRMINGHAM-BARTLETT DRILLING CO.

(Signature) By Richard Hindery Partner
300 Kaufman Bldg., Wichita 2, Kansas
(Address)

SUBSCRIBED AND SWORN TO before me this 9th day of October, 19 62.



Beverly Larson
Beverly Larson Notary Public.

COADY NO. 1 WELL

LOCATION: SW/4 SW/4 NW/4
 Section 32-135-13W
 Russell County, Kansas

SPUDDED: 9-23-62
 COMPLETED: 10-7-62

OWNER, OPERATOR
 and CONTRACTOR: Birmingham-Bartlett Drilling Co.
 300 Kaufman Building
 Wichita 2, Kansas

SURFACE CASING: 8-5/8" used casing cemented at
 192' with 140 sacks cement.

OIL STRING: None set. Dry hole. Plugged
 on 10-7-62.

LOG

(Figures indicate bottom of formation)

0 -	600	Shale and shells
	815	Shale and red bed
	853	Anhydrite
	1520	Shale and shells
	2735	Shale and lime
	2896	Lime
	3060	Lime and shale
	3090	Lime
	3145	Shale and lime
	3340	Lime
	3347	Chert and lime
	3370	Arbuckle
	3370	Rotary total depth

RECEIVED
 STATE CORPORATION COMMISSION
 10-10-1962
 OCT 10 1962
 CONSERVATION DIVISION
 Wichita, Kansas

The undersigned, Richard Hindery, one of the partners of Birmingham-Bartlett Drilling Co., hereby certifies that the above is a true and correct log of the COADY NO. 1 WELL as shown in the daily drilling reports.

BIRMINGHAM-BARTLETT DRILLING CO.

By Richard Hindery
 Richard Hindery, Partner

Subscribed and sworn to before me
 this 9th day of October, 1962.

Beverly Larson
 Beverly Larson, Notary Public
 My commission expires October 2, 1966.