

STATE OF KANSAS
STATE CORPORATION COMMISSION

WELL PLUGGING RECORD

OR
FORMATION PLUGGING RECORD


Strike out upper line when reporting plugging of formations.

Give All Information Completely
Make Required Affidavit
Mail or Deliver Report to:
Conservation Division
State Corporation Commission
800 Bittling Building
Wichita, Kansas

Russell County, Sec. 32 Twp. 13 Rge. (E) 13 (W)

Location as "NE 1/4 NW 1/4 SW 1/4" or footage from lines NE NE NE
Lease Owner R. W. Rine Drilling Company
Lease Name Schmidt Well No. 1
Office Address 320 Central Bldg. - Wichita, Kansas
Character of Well (completed as Oil, Gas or Dry Hole) Completed as Dry Hole
Date well completed March 26, 1949 19
Application for plugging filed March 26, 1949 19
Application for plugging approved March 26, 1949 19
Plugging commenced March 26, 1949 @ 1 P.M. 19
Plugging completed March 26, 1949 @ 4 P. M. 19
Reason for abandonment of well or producing formation Dry Hole

NORTH

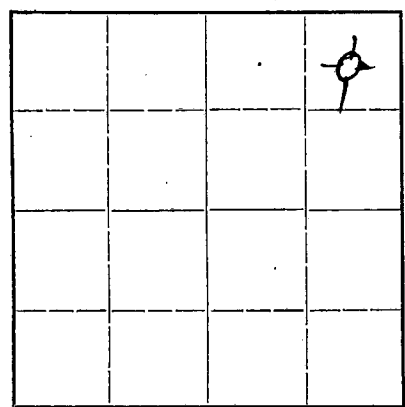

Locate well correctly on above Section Plat

If a producing well is abandoned, date of last production None 19

Was permission obtained from the Conservation Division or its agents before plugging was commenced? Yes E. Don Pett / Ollie Bryant - Great Bend, Kansas

Name of Conservation Agent who supervised plugging of this well
Producing formation None Depth to top Bottom Total Depth of Well 3407 Feet

Show depth and thickness of all water, oil and gas formations.

OIL, GAS OR WATER RECORDS

CASING RECORD

Formation	Content	From	To	Size	Put In	Pulled Out
Surface	Shale	0	225	8 5/8"	3/16/49	Cemented In

Describe in detail the manner in which the well was plugged, indicating where the mud fluid was placed and the method or methods used in introducing it into the hole. If cement or other plugs were used, state the character of same and depth placed, from 0' feet to 220' feet for each plug set.
Plug set @ 220' w/ 20 sacks cement - mud to 30' and plug set @ 30' w/10 sacks cement to surface.

RECEIVED
MAR 30 1949
STATE CORPORATION COMMISSION
KANSAS

(If additional description is necessary, use BACK of this sheet)

Correspondence regarding this well should be addressed to R. W. Rine Drilling Company
Address 320-Central Building - Wichita, Kansas

STATE OF Kansas, COUNTY OF Sedgwick, ss.

E. H. Sloyer (employee of owner) or (owner or operator) of the above-described well, being first duly sworn on oath, says: That I have knowledge of the facts, statements, and matters herein contained and the log of the above-described well as filed and that the same are true and correct. So help me God.

(Signature) E. H. Sloyer
320 Central Bldg. - Wichita, Kansas (Address)

SUBSCRIBED AND SWORN to before me this 28th day of March 19 49

R. M. Green Notary Public.

My commission expires Dec. 29, 1962

19-927 PLUGGING
FILE SEC 32T 13 R 13W
BACK PAGE 88 LINE 42

15-167-00353-00-00

Schmidt Well No. 1

NE NE NE
Section 32-13-13W
Russell County, Kansas

Contractor: The R. W. Rine Drilling Company
Started: 3-15-49 Finished: 3-26-49

Log

Shale	0- 225	
Shale and Shells	225- 815	8-5/8" W/ @ 225
Anhydrite	815- 853	
Red Bed and Shale	853-1040	
Shale and Shells	1040-1285	
Lime and Shale	1285-1560	
Salt and Shale	1560-1785	
Lime	1785-2115	
Lime and Shale	2115-2560	
Shale and Shells	2560-2690	
Lime and Shale	2690-3000	
Lime	3000-3295	
Lime and Shale	3295-3345	
Lime	3345-3407	TD 3407 D & A

Top Heebner	2953'
Top Kansas City	3018'
Top Conglomerate	3328'
Top Arbuckle	3350'

03-30-1949

State of Kansas)
County of Sedgwick) ss

I, E. H. Sloyer, do hereby certify that the above is a true and accurate log of the Schmidt Well No. 1 located in the NE/4 of the NE/4 of the NE/4 of Section 32-13-13W, Russell County, Kansas.

E. H. Sloyer
Assistant Secretary

Sworn to and subscribed before me this 29th day of March, 1949.

My commission expires Dec. 29, 1962

R. M. Green
Notary Public

PLUGGING
FILE SEC 32-13-13W
BOOK PAGE 58 LINE 42