

NOTICE OF INTENTION TO DRILL

Expected Spud Date. 10 10 1988 (see rules on reverse side)
month day year

API Number 15-167-22,824-00-00 DA

OPERATOR: License # 6588
Name Woodman-Iannitti Oil Company
Address P.O. Box 308
City/State/Zip Great Bend, Kansas 67530
Contact Person D. J. Iannitti
Phone (316) 792-2921

NE NE SE Sec. 13 Twp. 13 S, Rg. 13 XX East West
2310 Ft. from South Line of Section
330 Ft. from East Line of Section

(Note: Locate well on Section Plat on reverse side)

CONTRACTOR: License # 5122 90
Name Woodman-Iannitti Drilling Company
City/State Great Bend, Kansas

Nearest lease or unit boundary line 330 feet
County Russell
Lease Name DAUBER Well # 1

Well Drilled For: Well Class: Type Equipment:
XX Oil Storage Infield XX Mud Rotary
Gas Inj Pool Ext Air Rotary
OWWO Expl XX Wildcat Cable

Ground surface elevation feet MSL
Domestic well within 330 feet: yes X no
Municipal well within one mile: yes X no

If OWWO: old well info as follows:

Operator
Well Name
Comp Date Old Total Depth

Depth to bottom of fresh water 160
Depth to bottom of usable water 570
Surface pipe by Alternate: 1 2 X
Surface pipe planned to be set 200
Conductor pipe required
Projected Total Depth 3300
Formation Conglomerate

I certify that well will comply with K.S.A. 55-101, et seq., plus eventually plugging hole to KCC specifications.

Date 9/07/88 Signature of Operator or Agent D. J. Iannitti Title Partner


For KCC Use:

Conductor Pipe Required feet; Minimum Surface Pipe Required 200' feet per Alt. X 2
This Authorization Expires 3-9-89 Approved By LKM 9-9-88

EFFECTIVE DATE: 9-14-88

Must be filed with the K.C.C. five (5) days prior to commencing well
This card void if drilling not started within six (6) months of date received by K.C.C.

A Regular Section of Land
1 Mile = 5,280 Ft.

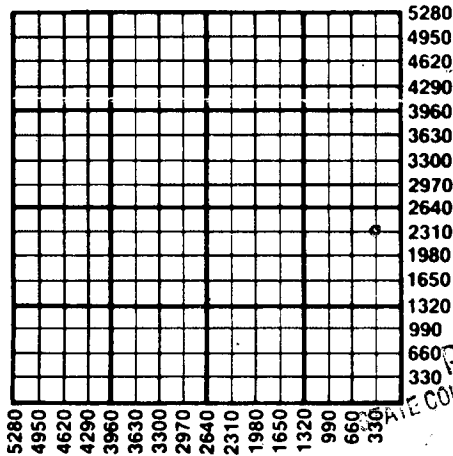

Important procedures to follow:

1. Notify District office before setting surface casing.
2. Set surface casing by circulating cement to the top.
3. File completion forms ACO-1 with K.C.C. within 120 days of well spud date, following instructions on ACO-1, side 1, and including copies of wireline logs.
4. Notify District office 48 hours prior to old well workover or re-entry.
5. Prior to filing Intent, prepare a proposed plugging plan in case well is D & A, then obtain approval of plan when calling district office prior to setting surface pipe.
6. Submit plugging report (CP-4) to K.C.C. after plugging is completed.
7. Obtain an approved injection docket number before disposing of salt water.
8. Notify K.C.C. within 10 days when injection commences or terminates.

RECEIVED
STATE CORPORATION COMMISSION
SEP - 8 1988
09-08-1988
CONSERVATION DIVISION
Wichita, Kansas

of an alternate 2 completion, cement in the production pipe from
top of any usable water to surface within 120 days of spud date.

State Corporation Commission of Kansas
Conservation Division
200 Colorado Derby Building
Wichita, Kansas 67202-1212
(316) 263-3238