

CARD MUST BE TYPED

State of Kansas

CARD MUST BE SIGNED

NOTICE OF INTENTION TO DRILL

(see rules on reverse side)

15-051-24442-00-00

Starting Date 10-24-86 month day year 3/4

API Number 15- 051-24442 East

OPERATOR: License # 6033 Name Murfin Drilling Company Address 250 N. Water, Suite 300 City/State/Zip Wichita, Ks. 67202

C. W./2. E./2. NE/4 Sec. 34 Twp. 11. S, Rg. 16. 3960 Ft. from South Line of Section 990 Ft. from East Line of Section

(Note: Locate well on Section Plat on reverse side)

Contact Person David Doyel Phone 316-267-3241

Nearest lease or unit boundary line 990' east feet County Ellis

CONTRACTOR: License # 6033 Name Murfin Drilling Company City/State Wichita, Ks. 67202

Lease Name CHRISLER "A" Well # 3 Ground surface elevation 1839 feet MSL

Well Drilled For: Well Class: Type Equipment: X Oil SWD Infield Mud Rotary Gas Inj Pool Ext Air Rotary OWWO Expl Wildcat Cable

Domestic well within 330 feet: yes X no Municipal well within one mile: yes X no Depth to bottom of fresh water 175 Depth to bottom of usable water 1600 500 Surface pipe by Alternate: 1 2 X

If OWWO: old well info as follows: Operator Well Name Comp Date Old Total Depth

Surface pipe planned to be set 250 Conductor pipe required none Projected Total Depth 3500 Formation

I certify that well will comply with K.S.A. 55-101, et seq., plus eventually plugging hole to KCC specifications.


Date 10-22-86 Signature of Operator or Agent DAVID DOYEL Title

For KCC Use: Conductor Pipe Required 4 feet; Minimum Surface Pipe Required 250 feet per Alt. 2 This Authorization Expires 10-22-87 Approved By

Signature

Must be filed with the K.C.C. five (5) days prior to commencing well
This card void if drilling not started within six (6) months of date received by K.C.C.

A Regular Section of Land
1 Mile = 5,280 Ft.

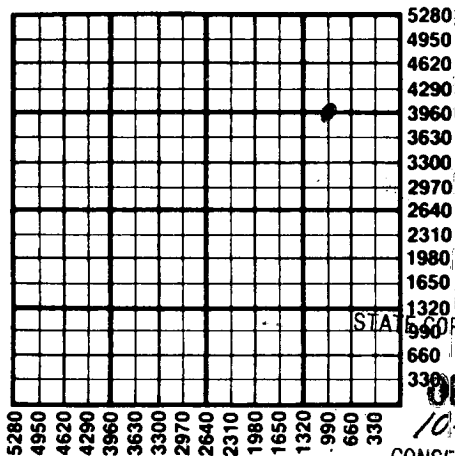

RECEIVED
STATE CORPORATION COMMISSION
OCT 22 1986
10-22-1986
CONSERVATION DIVISION
Wichita, Kansas

Important procedures to follow:

1. Notify District office before setting surface casing.
2. Set surface casing by circulating cement to the top.
3. File completion forms ACO-1 with K.C.C. within 90 days of well completion, following instructions on ACO-1, side 1, and including copies of wireline logs.
4. Notify District office 48 hours prior to old well workover or re-entry.
5. Prior to filing Intent, prepare a proposed plugging plan in case well is D & A, then obtain approval of plan when calling district office prior to setting surface pipe.
6. Submit plugging report (CP-4) to K.C.C. after plugging is completed.
7. Obtain an approved injection docket number before disposing of salt water.
8. Notify K.C.C. within 10 days when injection commences or terminates.
9. If an alternate 2 completion, cement in the production pipe from below any usable water to surface within 120 days of spud date.

State Corporation Commission of Kansas
Conservation Division
200 Colorado Derby Building
Wichita, Kansas 67202
(316) 263-3238