

STATE OF KANSAS
STATE CORPORATION COMMISSION


WELL PLUGGING RECORD

Give All Information Completely
Make Required Affidavit
Mail or Deliver Report to
Conservation Division
State Corporation Comm.
245 North Water
Wichita, KS 67202

Russell County. Sec. 1 Twp. 13 Rge 14 W XR/W
Location as "NE/CNW $\frac{1}{4}$ SW $\frac{1}{4}$ " or footage from lines _____

NE SE NE
Lease Owner Dreiling Oil, Inc.
Lease Name Bachman Well No. 1

Office Address Rt#1, Victoria, KS 67671
Character of Well (Completed as Oil, Gas or Dry Hole) _____

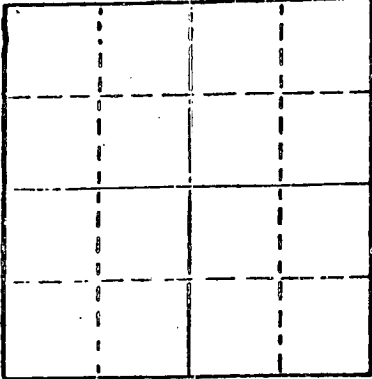

Locate well correctly on above
Section Plot

Dry Hole
Date Well completed 8-27 1978
Application for plugging filed 8-27 1978
Application for plugging approved 8-27 1978
Plugging commenced 8-27 1978
Plugging completed 8-27 1978
Reason for abandonment of well or producing formation _____

Dry Hole
If a producing well is abandoned, date of last production _____ 19____

Was permission obtained from the Conservation Division or its agents before plugging was commenced? yes

Name of Conservation Agent who supervised plugging of this well Duane Rankin
Producing formation _____ Depth to top _____ Bottom _____ Total Depth of Well 3083'
Show depth and thickness of all water, oil and gas formations.

OIL, GAS OR WATER RECORDS

CASING RECORD

FORMATION	CONTENT	FROM	TO	SIZE	PUT IN	PULLED OUT
Surface Pipe				8 5/8"	166'	0'

Describe in detail the manner in which the well was plugged, indicating where the mud fluid was placed and the method or methods used in introducing it into the hold. If cement or other plugs were used, state the character of same and depth placed, from _____ feet to _____ feet for each plug set.

- 1st plug was set @ 420' w/40 sacks cement
- 2nd plug was set @ 180' w/25 sacks cement
- 3rd plug was set @ 40' w/10 sacks cement

RECEIVED
STATE CORPORATION COMMISSION
SEP 01 1978
09-01-1978
CONSERVATION DIVISION
Wichita, Kansas

(If additional description is necessary, use BACK of this sheet)

Name of Plugging Contractor Dreiling Oil, Inc.

STATE OF KANSAS COUNTY OF ELLIS, ss.
I, Joseph A. Hess, Sec. Treas. of Drlg. Contrc. (employee of owner) or (owner or operator) of the above-described well, being first duly sworn on oath, says: That I have knowledge of the facts, statements, and matters herein contained and the log of the above-described well as filed and that the same are true and correct. So help me God.

(Signature) Joseph A. Hess
JOSEPH A. HESS, HAYS, KS 67601
(Address)

SUBSCRIBED AND SWORN TO before me this 31st day of August, 19 78

My commission expires November 17, 1980.

Cecilia Basgall
Cecilia Basgall Notary Public.
CECILIA BASGALL
NOTARY PUBLIC
Ellis County, Kansas

DREILING OIL, INC. 15-167-21227-00-00

Victoria, Kansas 67671

WELL LOG

Company	Dreiling Oil, Inc. Rt. #1 Victoria, KS 67671	Sec. 1	Twp. 13	Rng. 14
Farm	Bachman No. 1	Location	NE SE NE	
Total Depth	3,083'	County	Russell	
Comm.	8-21-78	Comp.	8-27-78	Elevation: 1670
Contractor	Dreiling Oil, Inc. Rt. #1 Victoria, KS 67671		1667	K. B.
			1665	D. E.
				G. R.

Casing Record
166' - 8 5/8"

Cement Record
125 sacks cement

Production:
D & A

Figures Indicate Bottom of Formations

0'	322'	Shale
322'	685'	Shale
685'	725'	Anhydrite
725'	1388'	Shale
1388'	1670'	Shale & Lime
1670'	2065'	Shale & Lime
2065'	2495'	Shale & Lime
2495'	3083'	Lime
3083'	T.D.	

RECEIVED
STATE CORPORATION COMMISSION

SEP 01 1978
09-01-1978
CONSERVATION DIVISION
Wichita, Kansas

STATE OF KANSAS)
)ss
COUNTY OF ELLIS)

I, Joseph A. Hess, Secretary Treasurer of Dreiling Oil, Inc., upon oath states that the above and foregoing is a true and correct copy from the Daily Drilling Report from the Bachman #1.


JOSEPH A. HESS

Subscribed and sworn to before me this 31st day of August, 1978.


Cecilia Basgall Notary Public

CECILIA BASGALL
NOTARY PUBLIC
Ellis County, Kansas

My appointment expires: November 17, 1980.