


WELL PLUGGING RECORD

Give All Information Completely
Make Required Affidavit
Mail or Deliver Report to:
Conservation Division
State Corporation Commission
800 Bitting Building
Wichita, Kansas

NORTH

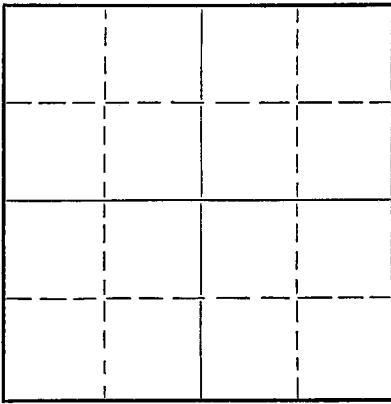

Locate well correctly on above
Section Flat

Russell County. Sec. 9 Twp. 13 Rge. 11 (E) W (W)
Location as "NE/CNW $\frac{1}{4}$ /SW $\frac{1}{4}$ " or footage from lines SW SW SE
Lease Owner John Lindas Oil, Inc.
Lease Name Solbach Well No. 1
Office Address 1316 Union National Bank Building, Wichita, Kansas
Character of Well (completed as Oil, Gas or Dry Hole) Dry Hole
Date well completed Nov. 20 19 52
Application for plugging filed Nov. 19 19 52
Application for plugging approved Nov. 19 19 52
Plugging commenced Nov. 20 19 52
Plugging completed Nov. 20 19 52
Reason for abandonment of well or producing formation Dry Hole

If a producing well is abandoned, date of last production 19
Was permission obtained from the Conservation Division or its agents before plugging was commenced? Yes.

Name of Conservation Agent who supervised plugging of this well C. D. Stough
Producing formation Depth to top Bottom Total Depth of Well 3340' Feet
Show depth and thickness of all water, oil and gas formations.

OIL, GAS OR WATER RECORDS

CASING RECORD

Formation	Content	From	To	Size	Put In	Pulled Out

Describe in detail the manner in which the well was plugged, indicating where the mud fluid was placed and the method or methods used in introducing it into the hole. If cement or other plugs were used, state the character of same and depth placed, from feet to feet for each plug set.

Set plug @ 158' ~~ft~~ with 15 sacks cement filled to 40' set plug with 16 sacks cement, completed @ 3:00 am Nov. 20, 1952.

NOV 21 1952 11-21-1952

CONSERVATION DIVISION
Wichita, Kansas

(If additional description is necessary, use BACK of this sheet)

Name of Plugging Contractor John Lindas Oil, Inc.
Address 1316 Union National Bank Building, Wichita, Kansas


STATE OF Kansas COUNTY OF Sedgwick, ss.
I, Fred Moore (employee of owner) or (owner or operator) of the above-described well, being first duly sworn on oath, says: That I have knowledge of the facts, statements, and matters herein contained and the log of the above-described well as filed and that the same are true and correct. So help me God.

(Signature) Fred Moore
1316 Union National Bank Bldg, Wichita, Kansas (Address)

SUBSCRIBED AND SWORN to before me this 20th day of November, 19 52

Edward W. Wiens
Notary Public.

My commission expires October 8, 1955

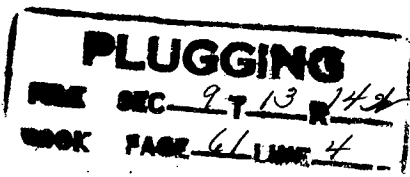

DRILLING LOG

Lease Operator: John Lindas Oil, Inc. County: Russell
 1316 Union National Bank Bldg. Location: SW SW SE
 Wichita 2, Kansas SECTION: 9-13S-14W
 Elevation: 1816' DF
 1813 GR.

Well: Solbach No. 1
 Rotary Total Depth: 3340'
 Commenced: November 8, 1952
 Completed: November 19, 1952
 Casing: 8-5/8" @ 160' with
 100 sacks of cement
 and 2 sacks of cal-
 cium chloride.

Contractor: John Lindas Oil, Inc.
 1316 Union National Bank Bldg.
 Wichita 2, Kansas

FIGURES INDICATE BOTTOM OF FORMATION

0	to	115	Sand
115		160	Shale
160		360	Shale and Shells
360		430	Sand and Iron
430		470	Sand and Shale
470		550	Shale
550		580	Sand
580		630	Blue Shale
630		865	Red Bed
865		900	Anhydrite Lime
900		1560	Shale and Shells
1560		2015	Lime
2015		2125	Lime and Shale
2125		2345	Shale and Shells
2345		2370	Lime and Shale
2370		2465	Broken Lime
2465		2705	Lime and Shale
2705		3300	Lime
3300		3323	Conglomerate Lime
3323		3340	Arbuckle Lime
		3340	TD

STATE OF KANSAS)
 : ss
 COUNTY OF SEDGWICK)

RECEIVED
 STATE CORPORATION COMMISSION
 11-21-1952
 NOV 21 1952

I, the undersigned, being only sworn on oath, depose and state that the above statement and log is a true and correct record of the well drilled by John Lindas Oil, Inc. at the location above described.

Edward W. Wiens

Subscribed and sworn to before me this 21st day of November, 1952

William Dancy
 Notary Public

My Commission expires: March 25, 1956.

PLUGGING
 FILE SEC 9-T-13-142
 BOOK PAGE 61-LINE 4