


WELL PLUGGING RECORD

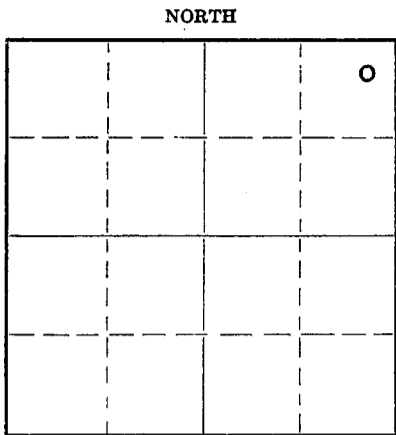

Locate well correctly on above Section Flat

Russell County. Sec. 3 Twp. 13 Rge. 14W (E) (W)
 Location as "NE/CNW $\frac{1}{4}$ /SW $\frac{1}{4}$ " or footage from lines NE NE NE
 Lease Owner Gough W. Davis
 Lease Name Krug Well No. 1
 Office Address 148 N. Crestway, Wichita, Kansas
 Character of Well (completed as Oil, Gas or Dry Hole) Dry Hole
 Date well completed October 23, 19 45
 Application for plugging filed January 3, 19 46
 Application for plugging approved January 7, 19 46
 Plugging commenced January 3, 19 46
 Plugging completed January 3, 19 46
 Reason for abandonment of well or producing formation Dry Hole

If a producing well is abandoned, date of last production none 19
 Was permission obtained from the Conservation Division or its agents before plugging was commenced? Yes

Name of Conservation Agent who supervised plugging of this well H. W. Kerr
 Producing formation Depth to top Bottom 3150 Total Depth of Well 3150 Feet
 Show depth and thickness of all water, oil and gas formations.

OIL, GAS OR WATER RECORDS

CASING RECORD

| Formation | Content | From | To | Size | Put In | Pulled Out |
|-----------|---------|------|----|-------|--------|------------|
| | | | | 8-5/8 | 210 | none |
| | | | | | | |
| | | | | | | |
| | | | | | | |
| | | | | | | |
| | | | | | | |
| | | | | | | |
| | | | | | | |
| | | | | | | |

Describe in detail the manner in which the well was plugged, indicating where the mud fluid was placed and the method or methods used in introducing it into the hole. If cement or other plugs were used, state the character of same and depth placed, from feet to feet for each plug set.

The hole was plugged back from 3150 feet to 2880 feet. Cement from 2880 feet to 2840 feet. (5 sacks) Heavy mud from 2840 feet to permanent bridge at 210 feet. Cement from 210 feet to 165 feet with 15 sacks. Heavy mud from 165 feet to 15 feet. Cement into base of cellar with 10 sacks. 210 feet of 8-5/8" cemented and left in hole

(If additional description is necessary, use BACK of this sheet)

Correspondence regarding this well should be addressed to Gough W. Davis, Address 148 N. Crestway, Wichita, Kansas

STATE OF KANSAS, COUNTY OF SEDGWICK, ss.
 (employee of owner) or (owner or operator) of the above-described well, being first duly sworn on oath, says: That I have knowledge of the facts, statements, and matters herein contained and the log of the above-described well as filed and that the same are true and correct. So help me God.

(Signature) *Gough W. Davis*
 148 North Crestway, Wichita, Kansas (Address)

SUBSCRIBED AND SWORN TO before me this 24th day of February, 19 49
 January 31, 1953
 My commission expires

Seward S. Greub
 Notary Public.

PLUGGING
 FILE SEC 3 T 13 R 24
 BOOK PAGE 39 LINE 7

02-24-1949

15-167-60520-00-00


WELL LOG BUREAU - KANSAS GEOLOGICAL SOCIETY
412 Union National Bk. Bldg., Wichita, Kansas

Company - GOUGH W. DAVIS ET AL
Farm - Krug No. 1.

SEC. 3 T. 13 R. 14 W
NEc NE

Total Depth. 3155
Comm. 10-1-45 Comp. 10-23-45
Shot or Treated.
Contractor. *H. J. Uhl*
Issued. 2-2-46

County. Russell
KANSAS

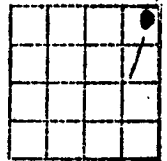

Elevation. _____

Production. Dry

CASING:

8" 134'
5" 3080'

Figures Indicate Bottom of Formations.

no log 95
red rock-sand red bed 195
shale & shells 330
red rock 455
shale & red rock 644
sand hrd 680
red rock 705
red rock & shale 1028
shale red & blue 1085
shale & salt 1150
salt 1220
shale & shells 1435
lime 1480
shale 1500
lime 1512
shale 1570
lime 1585
shale 1600
lime 1610
lime & chert 1650
lime 1685
lime & shale 1715
lime - chert 1805
shale - lime 1870
lime 1875
shale & lime 2000
lime 2035
lime & shale 2183
sand 2193
shale 2230
shale & lime 2447
lime 2450
shale & shells 2517
lime 2539
shale -lime sand 2555
lime 2615
shale & lime 2646
lime brkn 2683
lime 2740
shale & lime 2817
lime 2835
oil show 2835-2836
lime 2836
sand lime 2845
lime 2866
lime - lime sdy brkn 2913
lime 2936
chert 2944
lime/ 2955
lime- lime sdy 3000
lime 3141
lime Arbuckle 3155
Total Depth

Tops:
Anhydrite 640
Lansing - K.C. 2780
Arbuckle 3145

JAN 10 1949
01-10-1949
WICHITA, KANSAS

PLUGGING
FILE SEC 3 T 13 R 14
BOOK PAGE 39 LINE 37