

NOTICE OF INTENTION TO DRILL

(see rules on reverse side) 15-051-24440-00-00

Starting Date ... 10-17-86 ... month day year

API Number 15- 051-24,440

OPERATOR: License # 4794
Name Big Bear Resources, Inc.
Address 3000 Broadway - Suite C
City/State/Zip Hays, Kansas 67601
Contact Person Isidore P. Kisner
Phone 913 625-1145

SW NW NW 1/4 Sec 2 Twp 11 S, Rg 17
4290' Ft. from South Line of Section
4950' Ft. from East Line of Section

(Note: Locate well on Section Plat on reverse side)

CONTRACTOR: License # Unknown
Name
City/State

Nearest lease or unit boundary line 330' feet

County Ellis

Lease Name Anderson Well # 1

Ground surface elevation NA feet MSL

Well Drilled For: Well Class: Type Equipment:
[X] Oil [] SWD [] Infield [X] Mud Rotary
[] Gas [] Inj [X] Pool Ext. [] Air Rotary
[] OWWO [] Expl [] Wildcat [] Cable

Domestic well within 330 feet: [] yes [X] no

Municipal well within one mile: [] yes [X] no

Surface pipe by Alternate: 1X 2 []

Depth to bottom of fresh water 200'

Depth to bottom of usable water 600' 700'

Surface pipe planned to be set 1000'

Projected Total Depth 3500' feet

Formation K.C. Arb

If OWWO: old well info as follows:
Operator
Well Name
Comp Date Old Total Depth

I certify that well will comply with K.S.A. 55-101, et seq., plus eventually plugging hole to KCC specifications.

Date 10-14-86 Signature of Operator or Agent Isidore P. Kisner Title Operator

For KCC Use: Conductor Pipe Required feet; Minimum Surface Pipe Required 720 feet per Alt. 1 9

This Authorization Expires 4-15-87 Approved By 10-15-86

Handwritten signature/initials

Must be filed with the K.C.C. five (5) days prior to commencing well
 This card void if drilling not started within six (6) months of date received by K.C.C.


RECEIVED
 STATE CORPORATION COMMISSION
 CONS. DIV. WICHITA, KS

Important procedures to follow:

A Regular Section of Land
 1 Mile = 5,280 Ft.

10-15-1986
 OCT 15 1985

1. Notify District office before setting surface casing.
2. Set surface casing by circulating cement to the top.
3. File completion forms ACO-1 with K.C.C. within 90 days of well completion, following instructions on ACO-1, side 1, and including copies of wireline logs.
4. Notify District office 48 hours prior to old well workover or re-entry.
5. Prior to filing Intent, prepare a proposed plugging plan in case well is D & A, then obtain approval of plan when calling district office prior to setting surface pipe.
6. Submit plugging report (CP-4) to K.C.C. after plugging is completed.
7. Obtain an approved injection docket number before disposing of salt water.
8. Notify K.C.C. within 10 days when injection commences or terminates.
9. If an alternate 2 completion, cement in the production pipe from below any usable water to surface within 120 days of spud date.

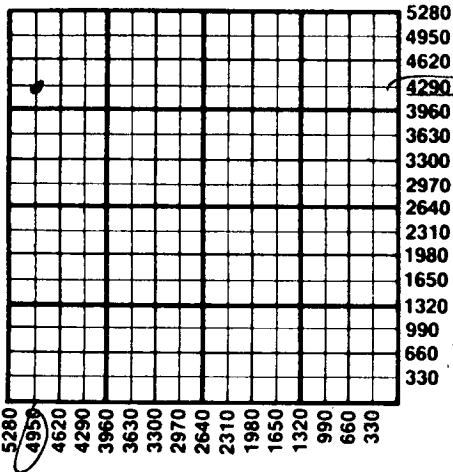

State Corporation Commission of Kansas
 Conservation Division
 200 Colorado Derby Building
 Wichita, Kansas 67202
 (316) 263-3238