


15-051-30252-00-00  
WELL PLUGGING RECORD

Give All Information Completely  
Make Required Affidavit  
Mail or Deliver Report to:  
Conservation Division  
State Corporation Commission  
211 No. Broadway  
Wichita, Kansas

NORTH

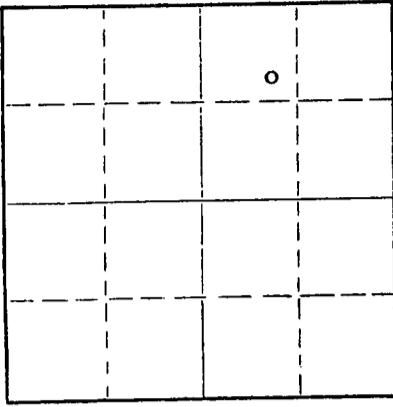

Locate well correctly on above  
Section Plat

Ellis County, Sec. 5 Twp. 11S Rge. 17W (E) (W)

Location as "NE/CNWxSWx" or footage from lines SE NW NE

Lease Owner Kern Drilling Company, Inc. and Hellar Drilling Company, Inc.

Lease Name Madden Well No. 1

Office Address 337 Union Center, Wichita, Kansas 67202

Character of Well (completed as Oil, Gas or Dry Hole) Dry Hole

Date well completed April 14 19 66

Application for plugging filed April 14 19 66

Application for plugging approved April 14 19 66

Plugging commenced April 14 19 66

Plugging completed April 14 19 66

Reason for abandonment of well or producing formation Dry Hole

If a producing well is abandoned, date of last production 19

Was permission obtained from the Conservation Division or its agents before plugging was commenced? Yes

Name of Conservation Agent who supervised plugging of this well Leo Massey, Box 582, Hays, Kansas

Producing formation Depth to top Bottom Total Depth of Well 3701 Feet

Show depth and thickness of all water, oil and gas formations.

OIL, GAS OR WATER RECORDS

CASING RECORD

FORMATION	CONTENT	FROM	TO	SIZE	PUT IN	PULLED OUT
		0	206'	8 5/8"	206'	none

Describe in detail the manner in which the well was plugged, indicating where the mud fluid was placed and the method or methods used in introducing it into the hole. If cement or other plugs were used, state the character of same and depth placed, from feet to feet for each plug set.

Set Plug: 540'/25 sacks cement  
200'/20 sacks cement  
40'/10 sacks cement

RECEIVED  
STATE CORPORATION COMMISSION  
4-21-1966  
APR 21 1966

CONSERVATION DIVISION  
Wichita, Kansas

(If additional description is necessary, use BACK of this sheet)

Name of Plugging Contractor Hellar Drilling Company, Inc.  
Address 1014 Union Center, Wichita, Kansas 67202

STATE OF Kansas, COUNTY OF Sedgwick, ss.

D.L. Hellar, Pres. of Hellar Drilling Co. Inc. (employee of owner) or (owner or operator) of the above-described well, being first duly sworn on oath, says: That I have knowledge of the facts, statements, and matters herein contained and the log of the above-described well as filed and that the same are true and correct. So help me God.

(Signature) D.L. Hellar D. L. Hellar, Pres.  
1014 Union Center, Wichita, Kansas 67202  
(Address)

SUBSCRIBED AND SWORN TO before me this 20th day of April, 19 66

March 25, 1968  
My commission expires  
Catherine Darcey  
Catherine Darcey Notary Public.

DRILLERS LOG

15-051-30252-00-00

COMPANY:

Kern Drilling Company, Inc. and  
Hellar Drilling Company, Inc.  
Hellar Drilling Company, Inc.

CONTRACTOR:

#1 Madden

LEASE:

SE NW NE 5-11S-17W, Ellis County, Kansas

LOCATION:

April 5, 1966

COMMENCED:

April 14, 1966

COMPLETED:

Set 8 5/8" surface casing @ 206'/200 sacks  
cement

CASING:

0-206	Blue shale
206-385	Shale & shells
385-710	Shale & Red Beds
710-758	Sand & Pyrite
758-940	Pyrite - sand & shale
940-1320	Red Bed and shale
1320-1358	Anhydrite
1358-1363	Shale
1363-1605	Shale & Lime streaks
1605-1900	Shale & shells
1900-2192	Cherty lime
2192-2357	Shale & lime
2357-2900	Lime & shale
2900-3055	Shale & lime
3055-3118	Lime
3118-3230	Topeka Section
3230-3352	(L. K.C.) Lime
3352-3425	K. C. Lime
3425-3608	Lime
3608-3645	Chert & shale
3645-3675	Cong. Chert & sand
3675-3701	Dolomite
3701	Rotary Total Depth

RECEIVED  
STATE CORPORATION COMMISSION  
4-21-1966  
APR 21 1966

CONSERVATION DIVISION  
WALTON, KANSAS

Dry & Abandoned

STATE OF KANSAS )  
                          ) ss  
COUNTY OF SEDGWICK )

I, D. L. Hellar, do hereby certify that the above and foregoing is a true and correct copy of the log of the #1 Madden, located in SE NW NE Sec. 5-11S-17W, Ellis County, Kansas, as reflected by the files of the Hellar Drilling Company, Inc.

HELLAR DRILLING COMPANY, INC.

By D. L. Hellar  
President - D. L. Hellar

Subscribed and sworn to before me, a Notary Public, in and for Sedgwick County, Kansas, this 20th day of April, 1966.

My Commission Expires:  
March 25, 1968

Catherine Darcey  
Notary Public - Catherine Darcey