


Give All Information Completely  
Make Required Affidavit  
Mail or Deliver Report to:  
Conservation Division  
State Corporation Commission  
212 No. Market  
Wichita, Kansas

15-051-06107-00-00  
WELL PLUGGING RECORD

Ellis County. Sec. 6 Twp. 11 Rge. 17 (W)

Location as "NE/CNW&SW" or footage from lines SW/4 SW/4 SE/4  
Lease Owner Pan American Petroleum Corporation  
Lease Name K. Gumble Well No. 1  
Office Address Box 432, Liberal, Kansas  
Character of Well (completed as Oil, Gas or Dry Hole) Oil  
Date well completed May 2 1939  
Application for plugging filed February 8 1968  
Application for plugging approved February 9 1968  
Plugging commenced March 9 1968  
Plugging completed March 13 1968  
Reason for abandonment of well or producing formation Depleted

NORTH

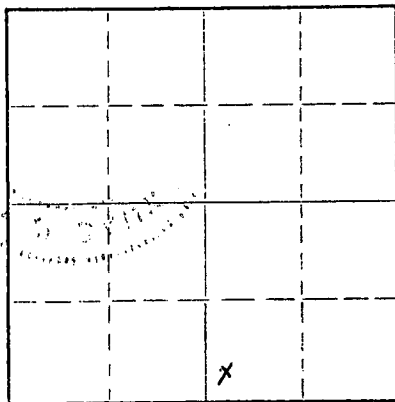

Locate well correctly on above Section Plat

If a producing well is abandoned, date of last production 12-5 1967  
Was permission obtained from the Conservation Division or its agents before plugging was commenced? Yes

Name of Conservation Agent who supervised plugging of this well Leo Massey  
Producing formation Arbuckle Depth to top 3442 Bottom 3445 Total Depth of Well 3445 Feet  
Show depth and thickness of all water, oil and gas formations.

OIL, GAS OR WATER RECORDS

CASING RECORD

FORMATION	CONTENT	FROM	TO	SIZE	PUT IN	PULLED OUT
Arbuckle	Oil-Depleted	3442	3445	10"	1152	None
				7"	3442	2098

Describe in detail the manner in which the well was plugged, indicating where the mud fluid was placed and the method or methods used in introducing it into the hole. If cement or other plugs were used, state the character of same and depth placed, from \_\_\_\_\_ feet to \_\_\_\_\_ feet for each plug set.

Dumped sand 3400-3445  
7 Sacks Cement 3352-3400  
Heavy Mud 400-3352  
Rock Bridge 390- 400  
8 Yards Cement 390- To Surface

RECEIVED  
STATE CORPORATION COMMISSION  
3-28-1968  
MAR 28 1968  
CONSERVATION DIVISION  
Wichita, Kansas

(If additional description is necessary, use BACK of this sheet)

Name of Plugging Contractor Knight Casing Pulling Company, Inc.  
Address Chase, Kansas

STATE OF Kansas, COUNTY OF Seward, ss.  
I, E. C. Woodall (employee of owner) or (owner or operator) of the above-described well, being first duly sworn on oath, says: That I have knowledge of the facts, statements, and matters herein contained and the log of the abandoned well as filed and that the same are true and correct. So help me God.


(Signature) E. C. Woodall E. C. WOODALL

P.O. Box 432, Liberal, Kansas (Address)

SWORN to before me this 26th day of March, 1968

R. W. Banks R. W. Banks  
Notary Public.

February 11, 1972

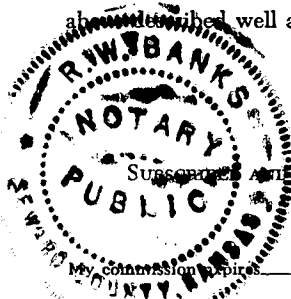

15-051-06107-00-00  
 THE DICKEY OIL COMPANY  
 Gumble No. 1

COMMENCED: April 4, 1939  
 COMPLETED: May 2, 1939

LOCATION: SW SW SE-6-11-17 West  
 Ellis County, Kansas  
 ELEVATION: 1891

CASING RECORD: 73' 15 $\frac{1}{2}$ "  
 1152' 10"  
 3442 $\frac{1}{2}$ ' 7" O.D.

red bed	20
sand	45
red bed	73
shale shells	159
shale	370
sand	460
shale shells	575
lime	584
shale shells	1000
broken lime	1083
shale shells	1095
red bed	1145
anhydrite	1155
lime	1180
shale and shells	1480
salt	1690
broken lime	1818
shale and shells	2124
lime	2155
shale	2165
shale and shells	2330
lime	2355
broken lime	2420
shale	2832
shale and shells	2855
broken lime	2900
top Topeka lime	2900
lime	2981
broken lime	3035
lime	3050
lime	3104
top K. C. lime	3104
lime	3364
lime and shale	3376
conglomerate	3388
broken lime	3405
dolomite	3430
green shale	3442
top Siliceous	3442 $\frac{1}{2}$
lime	3445
T. D.	3445

**RECEIVED**  
 STATE CORPORATION COMMISSION  
 FEB 9 - 1968  
 CONSERVATION DIVISION  
 Wichita, Kansas