


Give All Information Completely
Make Required Affidavit
Mail or Deliver Report to:
Conservation Division
State Corporation Commission
212 No. Market
Wichita, Kansas

15-051-03293-00-00
WELL PLUGGING RECORD

Ellis County. Sec. 6 Twp. 11 Rge. (E) 17 (W)
Location as "NE/CNW*SW*" or footage from lines N/2 SE/4 SW/4
Lease Owner Pan American Petroleum Corporation
Lease Name N. Henderson "B" Well No. 5
Office Address Box 432, Liberal, Kansas
Character of Well (completed as Oil, Gas or Dry Hole) Oil
Date well completed 1-10 19 68
Application for plugging filed 2-8 19 68
Application for plugging approved 2-9 19 68
Plugging commenced 3-13 19 68
Plugging completed 3-18 19 68
Reason for abandonment of well or producing formation Depleted

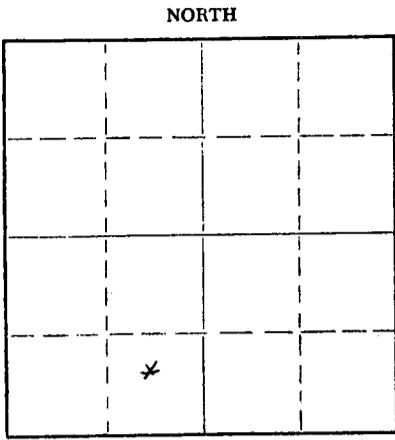

Locate well correctly on above Section Plat

If a producing well is abandoned, date of last production 12-4 19 66
Was permission obtained from the Conservation Division or its agents before plugging was commenced? Yes

Name of Conservation Agent who supervised plugging of this well Leo Massey
Producing formation Arbuckle Depth to top 3464 Bottom 3467 Total Depth of Well 3467 Feet
Show depth and thickness of all water, oil and gas formations.

OIL, GAS OR WATER RECORDS

CASING RECORD

FORMATION	CONTENT	FROM	TO	SIZE	PUT IN	PULLED OUT
Arbuckle	Oil-depleted	3464	3467	10"	1185	None
				7"	3464	2036

Describe in detail the manner in which the well was plugged, indicating where the mud fluid was placed and the method or methods used in introducing it into the hole. If cement or other plugs were used, state the character of same and depth placed, from _____ feet to _____ feet for each plug set.

Heavy Mud 3392-3467
7 Sk Cmt 3337-3392
Heavy Mud 420-3337
Rock Bridge 410- 420
155 Sk. Cmt 410- To Surface

RECEIVED
STATE CORPORATION COMMISSION
3-29-1968
MAR 29 1968
CONSERVATION DIVISION
Wichita, Kansas

(If additional description is necessary, use BACK of this sheet)

Name of Plugging Contractor Knight Casing Pulling Co., Inc.
Address Chase, Kansas

STATE OF Kansas, COUNTY OF Seward, ss.
I, E. C. Woodall (employee of owner) or (owner or operator) of the above-described well, being first duly sworn on oath, says: That I have knowledge of the facts, statements, and matters herein contained and the log of the above-described well as filed and that the same are true and correct. So help me God.

(Signature) E. C. WOODALL

Box 432, Liberal, Kansas
(Address)

Subscribed and Sworn to before me this 27th day of March, 1968

February 11, 1972

R. W. Banks
Notary Public.



15-051-03293-00-00
 THE DICKEY OIL COMPANY
 Henderson-B #5

COMMENCED: 12-21-40
 COMPLETED: 1-10-41

LOCATION: C/N $\frac{1}{2}$ SE $\frac{1}{4}$ SW $\frac{1}{4}$ 6-11-17
 Ellis County, Kansas
 ELEVATION: 1910

Pipe Record

1185' 10"
 3464' 7"

Shale	40
Shale and Shells	700
Sand	830
Red Bed	1168
Top Anhydrite	1168
Anhydrite	1210
Shale and Shells	1470
Salt	1690
Broken Lime	2347
Shale and Shells	2465
Shale	2522
Shale and Lime	2575
Shale and Shells	2860
Top Topeka	2860
Lime	2896
Lime and Shale	2928
Oil Smell	2966-2976
Lime	3160
Top K.C.	3160
Oil Smell	3176-3192
Lime	3370
Broken Lime	3395
Top Conglomerate	3395
Conglomerate	3442
Dolomite	3454
Green Shale	3466
Top Arbuckle	3466
Lime	3467 T.D.

NOTE: Top Siliceous is 3464'
 (Corrected to Derrick Floor)

CORRECTION:

Conglomerate	3440
Dolomite	3452
Green Shale	3464
Arbuckle Lime	3467 T.D.

RECEIVED
 STATE CORPORATION COMMISSION
 FEB 9 - 1968
 CONSERVATION DIVISION
 Wichita, Kansas