

STATE OF KANSAS
STATE CORPORATION COMMISSION
200 Colorado Derby Building
Wichita, Kansas 67202

15-051-00202-00-01
WELL PLUGGING RECORD
K.A.R.-82-3-117

APPLICANT NUMBER Rotary Completed 3-14-53

LEASE NAME McCombs

WELL NUMBER 1

TYPE OR PRINT
NOTICE: Fill out completely
and return to Cons. Div.
office within 30 days.

330 Ft. from S Section Line

2970 Ft. from E Section Line

SEC. 11 TWP. 11 RGE. 17 (●) or (W)

COUNTY Ellis

LEASE OPERATOR Palomino Petroleum

ADDRESS 4924 S.E. 84th Street, Newton, KS 67114

Date Well Completed 3-14-53

PHONE# (316) 283-0232 OPERATORS LICENSE NO. 5161

Plugging Commenced 12-3-90

Character of Well Input

Plugging Completed 12-3-90

(Oil, Gas, D&A, SWD, Input, Water Supply Well)

The plugging proposal was approved on 12-3-90 (date)

by Don Butcher (KCC District Agent's Name).

Is ACO-1 filed? 3-14-53 Drlg. Comp. Date
If not, is well log attached? Mailed with CP-1

Producing Formation _____ Depth to Top _____ Bottom _____ T.D. _____

Show depth and thickness of all water, oil and gas formations.

OIL, GAS OR WATER RECORDS

CASING RECORD

Formation	Content	From	To	Size	Put In	Pulled out
				8 5/8	188	None
				5 1/2	3360	None
				3 1/2	2950	None

Describe in detail the manner in which the well was plugged, indicating where the mud fluid was placed and the method or methods used in introducing it into the hole. If cement or other plugs were used, state the character of same and depth placed, from feet to feet each set. Hooked on 8 5/8" and pressured to 1000#. Pumped 110 sacks of 65-35 pozmix, 8% gel and 300# hulls down 3 1/2". Max. press. 1000#; SIP 400#. Hooked on backside of 3 1/2" pressured to 1000#.

(If additional description is necessary, use BACK of this form.)

Name of Plugging Contractor Palomino Petroleum/Allied Cementing License No. 5161

Address 4924 S.E. 84th Street, Newton, KS 67114

RECEIVED
STATE CORPORATION COMMISSION

NAME OF PARTY RESPONSIBLE FOR PLUGGING FEES: Bob Watchous

STATE OF KANSAS COUNTY OF HARVEY, ss.

JAN 15 1991
1-15-1991

R. W. Watchous (Employee of Operator) or (Operator) of above-described well, being first duly sworn on oath, says: That I have knowledge of these facts, statements, and matters herein contained and the log of the above-described well as filed that the same are true and correct, so help me God.

(Signature) R. W. Watchous


(Address) 4924 S.E. 84th Street
Newton, Kansas 67114

SUBSCRIBED AND SWORN TO before me this 12th day of December, 19 90

Kathryn L. Frerking
Notary Public

KATHRYN L. FRERKING
NOTARY PUBLIC
STATE OF KANSAS
MY APPT. EXPIRES 8-21-1993

Commission Expires: August 21, 1993

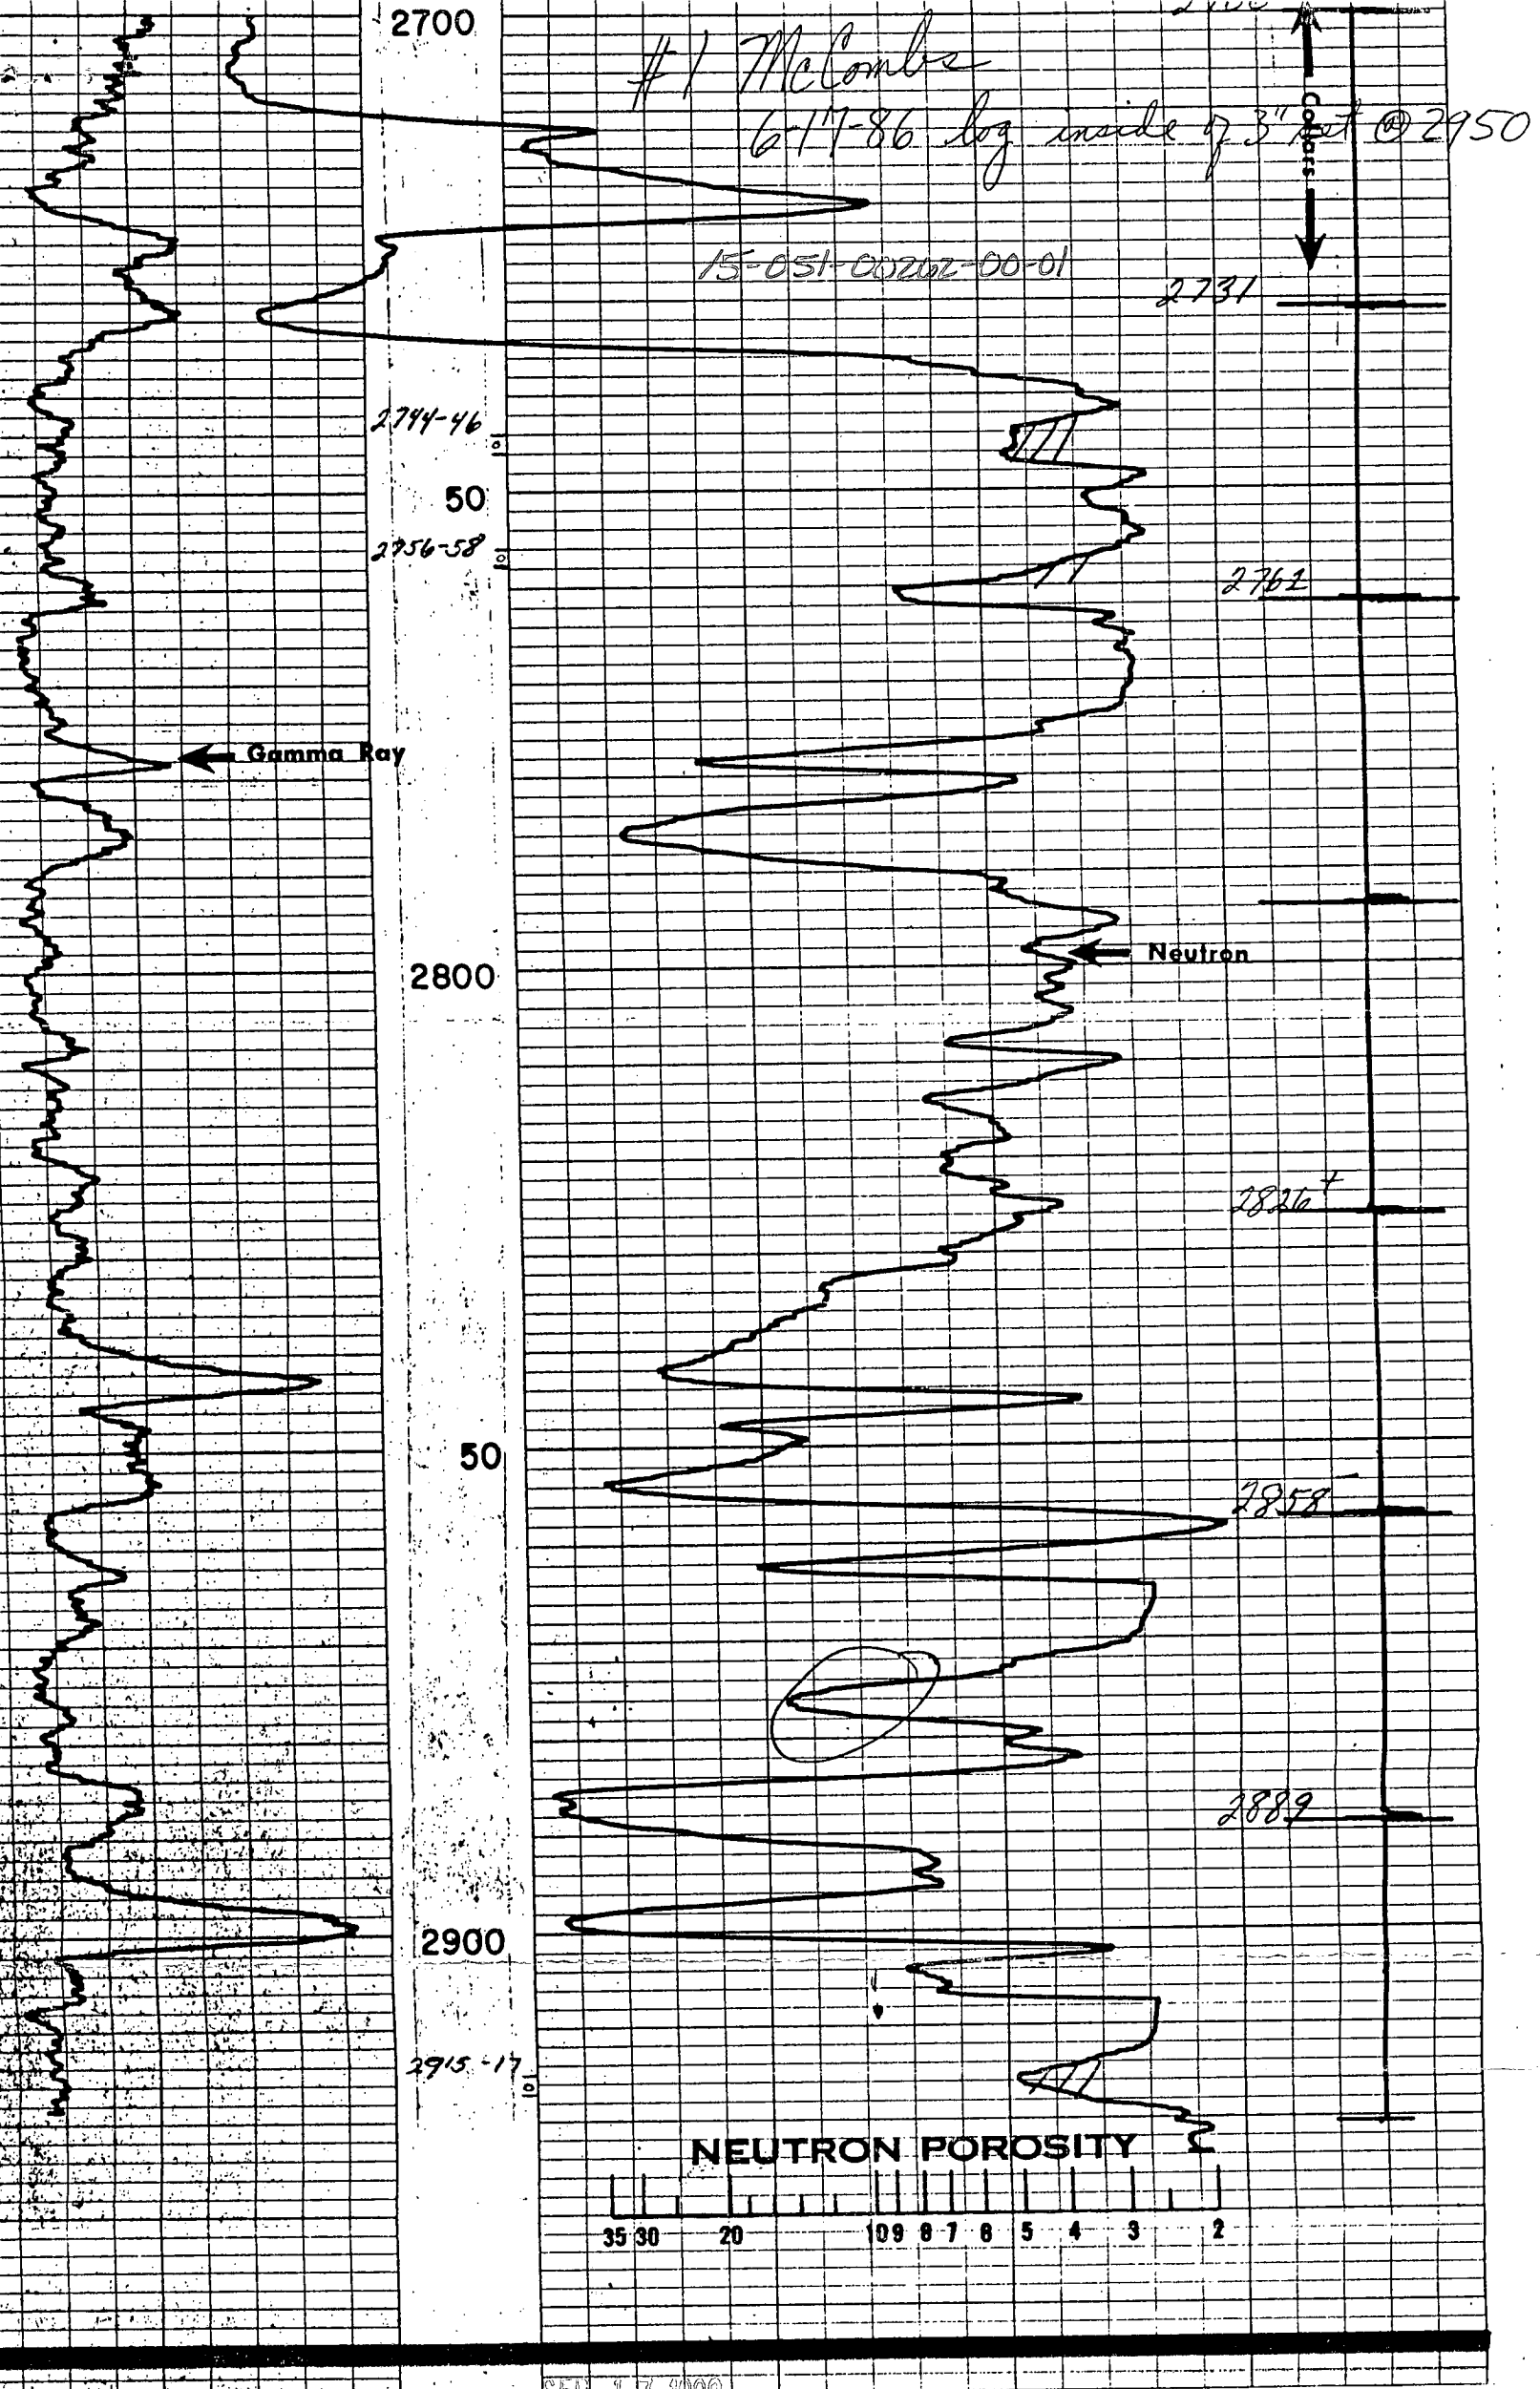

COMPANY Palomino Petro
 WELL McCombs No.1
 LOCATION Sec 11-11^s-12^w
 COUNTY Ellis Co. Ks.

SEP 17 1990
 9-17-1990

DRILLER T.D. 3364
 GREAT GUNS LOG T.D. 2925
 GREAT GUNS LOG F.R. 2924