


OR  
FORMATION PLUGGING RECORD

Strike out upper line  
when reporting plug-  
ging off formations.

Give All Information Completely  
Make Required Affidavit  
Mail or Deliver Report to:  
Conservation Division  
State Corporation Commission  
800 Bitting Building  
Wichita, Kansas

Ellis County. Sec. 11 Twp. 11S. Rge. 17(W)  
Location as "NE $\frac{1}{4}$ NW $\frac{1}{4}$ SW $\frac{1}{4}$ " or footage from lines. NW/4, NW/4, SW/4  
Lease Owner. The Bay Petroleum Corporation,  
Lease Name. McCombs 'B' Well No. 1  
Office Address. Box 957, Denver, Colorado.  
Character of Well (completed as Oil, Gas or Dry Hole) Dry Hole.  
Date well completed April, 22 19. 47  
Application for plugging filed April, 22 19. 47  
Application for plugging approved April, 22 19. 47  
Plugging commenced April, 22 19. 47  
Plugging completed April, 22 19. 47  
Reason for abandonment of well or producing formation Dry Hole

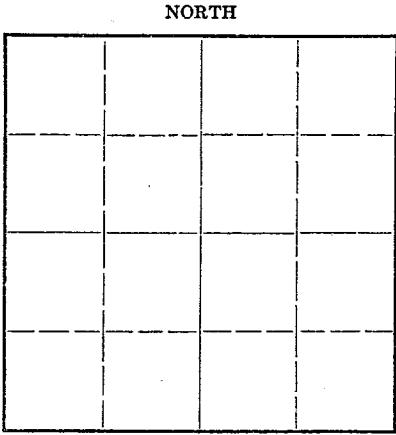

Locate well correctly on above  
Section Plat

If a producing well is abandoned, date of last production Dry Hole 19.  
Was permission obtained from the Conservation Division or its agents before plugging was com-  
menced? Yes.

Name of Conservation Agent who supervised plugging of this well Mr. C.D. Stough.  
Producing formation Arbuckle Test Depth to top 3375' Bottom 3400' Total Depth of Well 3400' Feet  
Show depth and thickness of all water, oil and gas formations.

OIL, GAS OR WATER RECORDS

CASING RECORD

Formation	Content	From	To	Size	Put In	Pulled Out
				8 5/8"	1025'	None

Describe in detail the manner in which the well was plugged, indicating where the mud fluid was placed and the method or methods used in introducing it into the hold. If cement or other plugs were used, state the character of same and depth placed, from feet to feet for each plug set.

Mudded hole to 1025',  
Plug at bottom of surface - 1025' - w/15sax cement,  
mudded hole to 240',  
Set plug at 240' w/75 sax cement,  
Cement circulated by Sun Cementing Co.

5-3-1947

(If additional description is necessary, use BACK of this sheet)

Correspondence regarding this well should be addressed to The Bay Petroleum Corporation,  
Address. Box 513, Chase, Kansas.

STATE OF Kansas COUNTY OF Rice, ss.  
Forrest Crawford (employee of owner) of the above-described well,  
being first duly sworn on oath, says: That I have knowledge of the facts, statements, and matters herein contained and the log of the above-described well as filed and that the same are true and correct. So help me God.

(Signature)

*Forrest Crawford*


(Address)

SUBSCRIBED AND SWORN to before me this 29 day of April, 1947

*Clarence O. Gray*

Notary Public.

My commission expires May 20, 1950

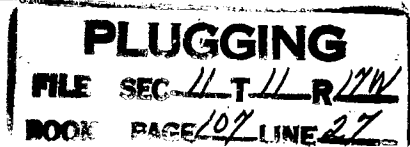

Location ; NW/4, NW/4, SW/4 Oil StringRun : None  
Sec. 11 - 11S - 17W - Ellis County. Kan.

Total Depth: 3402'

Operator: The Bay Petroleum Corporation,

Elevation : 1804 DF  
1806 KB

Contractor : H. H. & B. Drilling Co.

Casing:  
8 5/8" 1025'

Tops: Heebner 2983  
Lansing 3025  
Conglomerate 3296  
Simpson 3367  
Arbuckle 3375

Plugged and Abandoned - 4-2247.

LOG

Figures Indicate bottom of formations.

Clay sand and shells	0 to 75
sand and shells	285
shale and sand	345
shale and shells	560
sand	660
shale and shells	745
shale and rd bed	870
shale and shells	995
shale	1016
anhydrite	1050
sand and shale	1700
shale and lime shells	1820
lime and shale	2340
shale and lime shells	2440
lime and shale	3030
lime	3102
lime and shale	3125
lime	3157
shale and lime	3296
conglomerate	3344
conglomerate and shale	3376
sand	3377
Arbuckle Lime	3402

TOTAL DEPTH.

MAY 3-1947  
5-3-1947

**PLUGGING**  
FILE SEC 11 T 11 R 17W  
BOOK PAGE 107 LINE 27