


15-167-21104-00-00

STATE OF KANSAS
STATE CORPORATION COMMISSION

WELL PLUGGING RECORD

Give All Information Completely
Make Required Affidavit
Mail or Deliver Report to
Conservation Division
State Corporation Comm.
245 North Water
Wichita, KS 67202

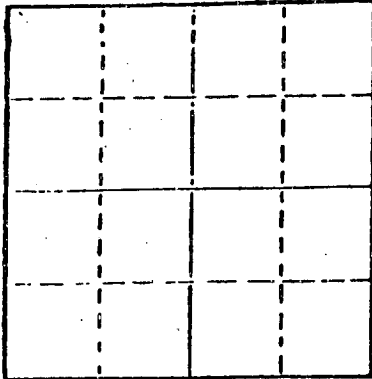

Locate well correctly on above
Section Plot

Russell County. Sec. 16 Twp. 13 Rge. 14 XE/W
Location as "NE/CNW 1/4 SW 1/4" or footage from lines
C-S 1/2 - SE - SE

Lease Owner Lewis Eulert
Lease Name McKinley Well No. 1

Office Address Paradise, KS 67658
Character of Well (Completed as Oil, Gas or Dry Hole) Dry Hole

Date Well completed 11-2 19 77
Application for plugging filed 11-2 19 77
Application for plugging approved 11-2 19 77
Plugging commenced 11-2 19 77
Plugging completed 11-2 19 77

Reason for abandonment of well or producing formation Dry Hole
If a producing well is abandoned, date of last production 19

Was permission obtained from the Conservation Division or its agents before plugging was commenced? yes

Name of Conservation Agent who supervised plugging of this well Duane Rankin
Producing formation _____ Depth to top _____ Bottom _____ Total Depth of Well 3303'
Show depth and thickness of all water, oil and gas formations.

OIL, GAS OR WATER RECORDS

CASING RECORD

FORMATION	CONTENT	FROM	TO	SIZE	PUT IN	PULLED OUT
Surface Pipe				8 5/8"	214'	0'

Describe in detail the manner in which the well was plugged, indicating where the mud fluid was placed and the method or methods used in introducing it into the hold. If cement or other plugs were used, state the character of same and depth placed, from _____ feet to _____ feet for each plug set.

1st plug was set @ 500' w/40 sacks cement
2nd plug was set @ 210' w/25 sacks cement
3rd plug was set @ 40' w/10 sacks cement

RECEIVED
STATE CORPORATION COMMISSION
NOV 10 1977
11-10-1977
CONSERVATION DIVISION
Wichita, Kansas

(If additional description is necessary, use BACK of this sheet)

Name of Plugging Contractor Dreiling Oil, Inc.

STATE OF KANSAS COUNTY OF ELLIS, ss.
I, Joseph A. Hess, Sec. Treas. of Drlg. Contrc. (employee of owner) or (owner or operator) of the above-described well, being first duly sworn on oath, says: That I have knowledge of the facts, statements, and matters herein contained and the log of the above-described well as filed and that the same are true and correct. So help me God.

(Signature)

Joseph A. Hess
JOSEPH A. HESS, HAYS, KS 67601
(Address)

SUBSCRIBED AND SWORN TO before me this 9th day of November, 1977

Cecilia Basgall
Cecilia Basgall Notary Public.

My commission expires November 17, 1980.

CECILIA BASGALL
NOTARY PUBLIC
Ellis County, Kansas

DREILING OIL, INC.

Victoria, Kansas 67671

15-167-21104-00-00

WELL LOG

Company	Lewis Eulert Paradise, KS 67658	Sec. 16	Twp. 13	Rng. 14		
Farm	McKinley No. 1	Location	C-S ¹ / ₂ - SE - SE			
Total Depth	3,303'	County	Russell			
Comm.	10-27-77	Comp.	11-2-77	Elevation:	1825	K. B.
Contractor	Dreiling Oil, Inc. Rt. #1 Victoria, KS 67671			1822	D. F.	
				1820	G. R.	

Casing Record
214' - 8 5/8"

Cement Record
150 sacks cement

Production:
D & A

Figures Indicate Bottom of Formations

0'	80'	Post Rock
80'	348'	Shale
348'	366'	Iron
366'	863'	Shale & Sand
863'	896'	Anhydrite
896'	1088'	Shale
1088'	1618'	Shale & Lime Shells
1618'	1860'	Shale
1860'	2330'	Shale & Lime
2330'	2542'	Shale
2542'	2797'	Lime & Shale
2797'	3303'	Lime
3303'	T.D.	

STATE OF KANSAS)
)ss
COUNTY OF ELLIS)

I, Joseph A. Hess, Secretary Treasurer of Dreiling Oil, Inc., upon oath states that the above and foregoing is a true and correct copy from the Daily Drilling Report from the McKinley #1.

Joseph A. Hess

JOSEPH A. HESS

Subscribed and sworn to before me this 9th day of November, 1977

CECILIA BASGALL
NOTARY PUBLIC
Ellis County, Kansas

Cecilia Basgall

Cecilia Basgall Notary Public

My appointment expires: November 17, 1980.

RECEIVED
STATE CONSERVATION COMMISSION
NOV 10 1977
11-10-1977
CONSERVATION DIVISION
Topeka, Kansas