


Give All Information Completely
Make Required Affidavit
Mail or Deliver Report to:
Conservation Division
State Corporation Commission
800 Bittling Building
Wichita, Kansas

OR
FORMATION PLUGGING RECORD

Strike out upper line
when reporting plug-
ging off formations.

NORTH

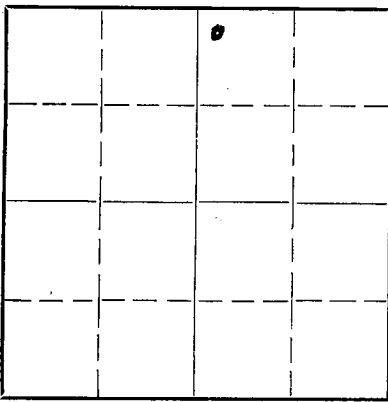

Locate well correctly on above
Section Plat

Russell County. Sec. 18 Twp. 13 Rge. 14 (E) W. (W)
Location as "NE $\frac{1}{4}$ NW $\frac{1}{4}$ SW $\frac{1}{4}$ " or footage from lines NW NW NE
Lease Owner Great Lakes Carbon Corporation
Lease Name Frank New "A" Well No. 1
Office Address 501 Petroleum Building, Wichita 2, Kansas
Character of Well (completed as Oil, Gas or Dry Hole) Dry Hole
Date well completed..... 6-30 19 45
Application for plugging filed..... 6-30 19 45
Application for plugging approved..... 6-30 19 45
Plugging commenced..... 6-30 19 45
Plugging completed..... 6-30 19 45
Reason for abandonment of well or producing formation..... Dry Hole

If a producing well is abandoned, date of last production..... 19.....
Was permission obtained from the Conservation Division or its agents before plugging was commenced?..... Yes

Name of Conservation Agent who supervised plugging of this well..... H. V. Kerr, Great Bend
Producing formation..... None Depth to top..... Bottom..... Total Depth of Well 3193 Feet
Show depth and thickness of all water, oil and gas formations.

OIL, GAS OR WATER RECORDS

CASING RECORD

Formation	Content	From	To	Size	Put In	Pulled Out
<u>Lansing-Kansas City</u>	<u>Dry</u>	<u>2899</u>	<u>3160</u>	<u>10-3/4</u>	<u>409</u>	<u>None</u>
<u>Arbuckle</u>	<u>Dry</u>	<u>3180</u>	<u>3193</u>			

Describe in detail the manner in which the well was plugged, indicating where the mud fluid was placed and the method or methods used in introducing it into the hole. If cement or other plugs were used, state the character of same and depth placed, from..... feet to..... feet for each plug set.

Heavy mud laden fluid circulated each 700 feet to 350

Bridged at 350

20 sacks cement at 350

Filled with mud to 26

26' to 6' - 10 sacks cement

PLUGGING
FILE = 18-13-1410
BOOK PAGE 19 LINE 25

(If additional description is necessary, use BACK of this sheet)

Correspondence regarding this well should be addressed to Great Lakes Carbon Corporation
Address 501 Petroleum Building, Wichita 2, Kansas

STATE OF Kansas, COUNTY OF Sedgwick, ss.
D. H. Sholtus (employee of owner) or (owner or operator) of the above-described well,

being first duly sworn on oath, says: That I have knowledge of the facts, statements, and matters herein contained and the log of the above-described well as filed and that the same are true and correct. So help me God.


(Signature) D. H. Sholtus

501 Pet. Building, Wichita 2, Ks
(Address)

SUBSCRIBED AND SWORN to before me this 6th day of July

Verdina B. Rutledge
Notary Public.

My commission expires March 15, 1948

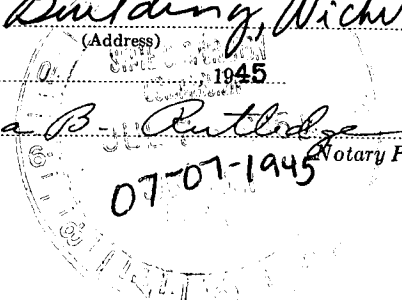

75-167-04754-00-00

GREAT LAKES CARBON CORPORATION
FRANK NEW "A" #1

NW NW NE
Sec. 18-13S-14W
Russell County, Kansas

TOTAL DEPTH 3193
COMM. 6-16-45
COMP. 6-30-45
CONTRACTOR KIOWA DRILLING CO.

ELEVATION 1719
CASING RECORD:
10-3/4" 401

0	
255	Shale and shells
408	Red Rock
795	Red Rock
820	Anhydrite
925	Sand and Red Rock
1100	Sand and Red Rock
1430	Salt and Shale
1550	Shale and lime
1570	Lime
1615	Hard Sand
1625	Shale
1825	Shale and lime
1865	Sandy lime
2095	Lime
2325	Shale and lime
2460	Shale
2585	Shale and lime
2640	Lime
2855	Lime
2895	Shale
3060	Lime
3040	Shale and lime
3160	Lime
3180	Conglomerate
3193 T.D.	Lime

We certify the foregoing to be a true and correct log of the above described well as kept by the drillers at the well.

GREAT LAKES CARBON CORPORATION

By D. H. Sholtus
D. H. Sholtus, Production
Superintendent

DRILLING
FILE # 18 13-14W
BOOK PAGE 19 NE 25

