


WELL PLUGGING RECORD

Give All Information Completely
Make Required Affidavit
Mail or Deliver Report to:
Conservation Division
State Corporation Commission
211 No. Broadway
Wichita, Kansas

NORTH

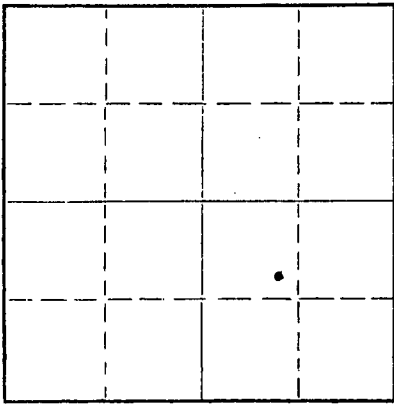

Locate well correctly on above Section Plat

Russell County, Sec. 18 Twp. 13s Rge. (E) 14 (W)
Location as "NE/CNW/SW" or footage from lines SE NW SE
Lease Owner WILKINSON DRILLING, INC.
Lease Name KRUG Well No. 1 'A'
Office Address 1121 Union National Building, Wichita 2, Kansas
Character of Well (completed as Oil, Gas or Dry Hole) Dry
Date well completed February 3, 1959
Application for plugging filed February 3, 1959
Application for plugging approved February 3, 1959
Plugging commenced February 3, 1959
Plugging completed February 3, 1959
Reason for abandonment of well or producing formation No commercial quantity of oil and/or gas was encountered.
If a producing well is abandoned, date of last production - 19-
Was permission obtained from the Conservation Division or its agents before plugging was commenced? Yes

Name of Conservation Agent who supervised plugging of this well Don Turon of Gorham, Kansas
Producing formation - Depth to top - Bottom - Total Depth of Well - Feet
Show depth and thickness of all water, oil and gas formations.

OIL, GAS OR WATER RECORDS

CASING RECORD

FORMATION	CONTENT	FROM	TO	SIZE	PUT IN	PULLED OUT

Describe in detail the manner in which the well was plugged, indicating where the mud fluid was placed and the method or methods used in introducing it into the hole. If cement or other plugs were used, state the character of same and depth placed, from - feet to - feet for each plug set.

Set bottom plug @ 300' with 25 sacks of cement and 1/4 sack of hulls.

Set top plug @ 40' with 10 sacks of cement and 1/4 sack of hulls.

RECEIVED
STATE CORPORATION COMMISSION

FEB 6 1959
02-06-1959
CONSERVATION DIVISION
Wichita, Kansas

(If additional description is necessary, use BACK of this sheet)
Name of Plugging Contractor WILKINSON DRILLING, INC.
Address 1121 Union National Building, Wichita 2, Kansas

STATE OF Kansas, COUNTY OF Sedgwick, ss.
Walter M. Wilkinson (employee of owner) or (owner or operator) of the above-described well, being first duly sworn on oath, says: That I have knowledge of the facts, statements, and matters herein contained and the log of the above-described well as filed and that the same are true and correct. So help me God.

(Signature) Walter M. Wilkinson
1121 Union National Bldg., Wichita 2, Kansas
(Address)

SUBSCRIBED AND SWORN TO before me this 5th day of February, 1959

My commission expires January 2, 1961

Carolyn K. Moore
Notary Public.

PLUGGING
FILE SEC. 18 T. 13 R. 14W
BOOK PAGE 18 LINE 17

15-167-05069-00-00

WILKINSON DRILLING, INC.
1121 Union National Building
Wichita 2, Kansas

RECEIVED
STATE CORPORATION DIVISION
02-06-1959
FEB 6 1959
CONSERVATION DIVISION
Wichita, Kansas

February 4, 1959

KRUG #1 'A'

Company	- WILKINSON DRILLING, INC.	Location	- SE NW SE, Sec. 18-13s-14w,
Contractor	- Company Tools		Russell County, Kansas
Commenced	- January 24, 1959	Elevation	- 1797' KB
Completed	- February 3, 1959	Casing	- 8 5/8" @ 310' w/200 sks
Total Depth	- 3249'		

FIGURES INDICATE BOTTOMS OF FORMATIONS

<u>Depth</u>	<u>Formations</u>
0 - 340	Shale and shells.
340 - 390	Sand and pyrite.
390 - 860	Shale and shells.
860 - 895	ANHYDRITE.
895 - 1530	Shale and shells.
1530 - 1940	Lime and shale.
1940 - 2170	Lime.
2170 - 3002	Lime and shale.
3002 - 3249	Lime.

We hereby certify the above and foregoing to be a true and correct copy of the Log on the KRUG #1 'A', located in the SE NW SE, Sec. 18-13s-14w, Russell County, Kansas.

WILKINSON DRILLING, INC.

Walter M. Wilkinson

Subscribed and sworn to before me this fourth day of February, nineteen hundred and fifty-nine.

Caroline F. Moore

My commission expires January 2, 1961.



PLUGGING
FILE SEC 18 T 13 R 14w
BOOK PAGE 18 LINE 17