

RECEIVED
STATE CORPORATION COMMISSION

FEB 13 1974

CONSERVATION DIVISION
Wichita, Kansas


Form CP-4

STATE OF KANSAS
STATE CORPORATION COMMISSION

WELL PLUGGING RECORD

Give All Information Completely
Make Required Affidavit
Mail or Deliver Report to:
Conservation Division
State Corporation Commission

P. O. Box 17027
Wichita, Kansas 67217
NORTH

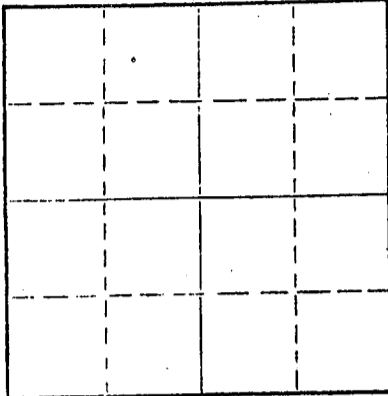

Locate well correctly on above
Section Plat

Ellis County, Sec. 7 Twp. 11 Rge. 17 (E) (W) X
Location as "NE/CNW&SW&" or footage from lines C-N/2-SE-NW
Lease Owner Sun Oil Company
Lease Name HENDERSON Well No. 4
Office Address Box 67 Hays, Kansas 67601
Character of Well (completed as Oil, Gas or Dry Hole)
Date well completed 19
Application for plugging filed 19
Application for plugging approved 19
Plugging commenced January 30, 1974
Plugging completed February 4, 1974
Reason for abandonment of well or producing formation Depleted

If a producing well is abandoned, date of last production 19
Was permission obtained from the Conservation Division or its agents before plugging was commenced? Yes

Name of Conservation Agent who supervised plugging of this well Leo Massey
Producing formation Depth to top Bottom Total Depth of Well 3455 Feet
Show depth and thickness of all water, oil and gas formations.

OIL, GAS OR WATER RECORDS

CASING RECORD

FORMATION	CONTENT	FROM	TO	SIZE	PUT IN	PULLED OUT
				16"	105	None
				10 3/4"	1142	None
				7"	3445	1872.97'

Describe in detail the manner in which the well was plugged, indicating where the mud fluid was placed and the method or methods used in introducing it into the hole. If cement or other plugs were used, state the character of same and depth placed, from feet to feet for each plug set.

Measured T.D. at 3450'. Dumped sand to 3430' and 5 sacks cement.
Shot casing at 2320, 2200, 2100, 2010 and 1900'. Pulled a total of
61 joints of 7" casing. Pushed a plug to 420'. Plugged well with 8
yds. readymix concrete.

(If additional description is necessary, use BACK of this sheet)

Name of Plugging Contractor Rockhold Engineering, Inc.
Address Box 698 Great Bend, Kansas 67530

STATE OF Kansas, COUNTY OF Barton, ss.
James W. Rockhold (employee of owner) or (owner or operator) of the above-described well, being first duly sworn on oath, says: That I have knowledge of the facts, statements, and matters herein contained and the log of the above-described well as filed and that the same are true and correct. So help me God.



CATHY MILLER
NOTARY PUBLIC
Barton County, Ks.

(Signature)

James W. Rockhold

Box 698 Gt. Bend, Ks. 67530
(Address)

James W. Rockhold

SUBSCRIBED AND SWORN to before me this 11th day of February, 1974

Cathy Miller
Cathy Miller Notary Public.


WELL LOG BUREAU - KANSAS GEOLOGICAL SOCIETY.
412 on National Bank Bldg, Wichita, Kas.

DARBY PETROLEUM CORP.
Henderson No. 4

SEC. 7 T 11 R. 17W.
CN $\frac{1}{2}$ SE NW

Total Depth. 3455 $\frac{1}{2}$
Comm. 10-5-39 Comp. 10-17-39
Shot or Treated. 1500 gal acid.
Contractor.
Issued. 11-4-39

County. Ellis.

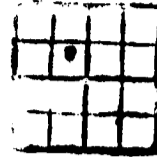

CASING.

15" 105' 10" 1142'
7" 3445 CTD.

Elevation.

Production. Pot. 3500 B.
Maximum

Figures Indicate Bottom of Formations.

sand	50
shale and shells	1137
anhydrite	1190
shale and red bed	1200
red bed shale and shells	1510
shale and shells	1605
salt	1705
shale and shells	1785
shale and lime	2595
shale	2675
shale and lime	2825
lime	3449
3449 equals 3446 SLM	
dolomite	3455 $\frac{1}{2}$
Total Depth.	

RECEIVED
STATE CORPORATION COMMISSION
DEC 14 1973
CONSERVATION DIVISION
Wichita, Kansas

Drilled plug at 3446
200' oil - 20 Min.
Drilled deeper 3450'
1000' oil 2 $\frac{1}{2}$ hrs.
Drilled deeper 3453 $\frac{1}{2}$
2800' oil 5 $\frac{1}{2}$ hrs.
Drilled deeper 3455 $\frac{1}{2}$
1500 gal acid.

Top Simpson 3422
Top Arbuckle 3445 Ctd.

22
23