


STATE OF KANSAS STATE CORPORATION COMMISSION

Give All Information Completely Make Required Affidavit Mail or Deliver Report to: Conservation Division State Corporation Commission 211 No. Broadway Wichita, Kansas

WELL PLUGGING RECORD

Ellis County, Sec. 7 Twp. 11 Rge. 17 (E) W (W) Location as "NE/CNW/SW" or footage from lines C E/2 NE SE Lease Owner Theodore Gore Lease Name Stein Well No. 1 Office Address Wichita, Kansas Character of Well (completed as Oil, Gas or Dry Hole) Date well completed Application for plugging filed Application for plugging approved Plugging commenced 12-9-63 Plugging completed 12-12-63 Reason for abandonment of well or producing formation Depleted.

If a producing well is abandoned, date of last production Was permission obtained from the Conservation Division or its agents before plugging was commenced? yes

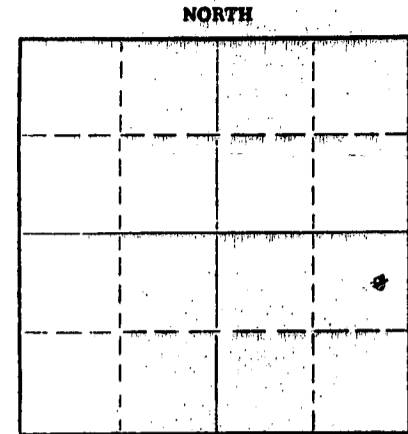

Locate well correctly on above Section Plat

Name of Conservation Agent who supervised plugging of this well Eldon Petty Producing formation Depth to top Bottom Total Depth of Well 3441 Feet Show depth and thickness of all water, oil and gas formations.

OIL, GAS OR WATER RECORDS

CASING RECORD

Table with 7 columns: FORMATION, CONTENT, FROM, TO, SIZE, PUT IN, PULLED OUT. Row 1: 8-5/8", 295', None. Row 2: 5-1/2", 3394', 2793'.

Describe in detail the manner in which the well was plugged, indicating where the mud fluid was placed and the method or methods used in introducing it into the hole. If cement or other plugs were used, state the character of same and depth placed, from feet to feet for each plug set.

Checked hole to 3394', sanded hole to 3300' and dumped 5 sacks of cement @ 3300' with dump bailer. Pulled 5 1/2" casing, checked mud to 900', pumped in 20 sacks of gel mud and 20 sacks of cement @ 500'. Mudded hole to 200' and dumped 20 sacks of cement. Mudded to 30' and ran 10 sacks of cement to base of cellar.

RECEIVED STATE CORPORATION COMMISSION

JAN 3 1964

PLUGGING COMPLETE.

CONSERVATION DIVISION Wichita, Kansas

(If additional description is necessary, use BACK of this sheet)

Name of Plugging Contractor KNIGHT CASING PULLING COMPANY Address CHASE, KANSAS

STATE OF KANSAS, COUNTY OF RICE, ss. Noel J. Knight (employee of owner) or former operator of the above-described well, being first duly sworn on oath, says: That I have knowledge of the facts, statements, and matters herein contained and the log of the above-described well as filed and that the same are true and correct. So help me God.

(Signature) Noel J. Knight Chase, Kansas (Address)

SUBSCRIBED AND SWORN to before me this 18th day of December, 1963

Milton J. Volin Notary Public.

My commission expires May 20, 1964

Harry Gore  
Stein #1

Sec. Sec. 7 Twp. 11 Rge. 17  
County: Ellis

Total Depth: 3393'  
Comm: 8/6/48 Comp: 8/21/48

Top Heebner Shale - 3032-34  
Top Lansing K.C. - 3075  
Top Conglomerate - 3338  
Top Simpson Shale - 3357  
Top Arbuckle - 3390

Casing  
8 5/8" Set @ 1095  
5 1/2" Set @ 3390

Cement  
500 Sx - Circulated  
100 Sx

Formation:	Depth:
Surface Clay	40
Shale & Snd.	50
Sand	65
Shale & Shells	380
Sand & Shale	430
Sand	460
Shale & Shells	620
Sand	765
Shale	790
Red Bed	845
Red Shale	885
Red Bed	992
Anhydrite	1140
Red Shale	1425
Salt	1595
Salt & Shale	1660
Shale & Shells	1936
Sandy Lime	2024
Lime	2104
Lime & Shale	2534
Shale	2665
Shale & Lime	2854
Lime	2975
Lime & Shale	3021
Lime	3394
Derrick Floor Correction	3392

**RECEIVED**  
STATE CORPORATION COMMISSION  
JAN 3 1964  
CONSERVATION DIVISION  
Wichita, Kansas

STATE OF KANSAS )  
                          ) SS  
COUNTY OF RUSSELL)

I hereby certify that the above information is true and correct to the best of my knowledge.

Subscribed and sworn to before me this 30th day of August, 1948.

Clara Lumme  
Notary Public

My Comm. Expires 6/17/50