

STATE OF KANSAS
STATE CORPORATION COMMISSION

Form CP-4


Give All Information Completely
Make Required Affidavit
Mail or Deliver Report to:
Conservation Division
State Corporation Commission
212 No. Market
Wichita, Kansas

WELL PLUGGING RECORD

Ellis County, Sec. 8 Twp. 11 Rge. 17 (E) W (W)

Location as "NE/CNW4SW4" or footage from lines NE SW NW
Lease Owner Meltzer Oil Company
Lease Name Gumble Well No. 4
Office Address Great Bend, Kansas
Character of Well (completed as Oil, Gas or Dry Hole) _____
Date well completed _____ 19____
Application for plugging filed _____ 19____
Application for plugging approved _____ 19____
Plugging commenced 9-19-66 _____ 19____
Plugging completed 9-21-66 _____ 19____
Reason for abandonment of well or producing formation Depleted.

NORTH

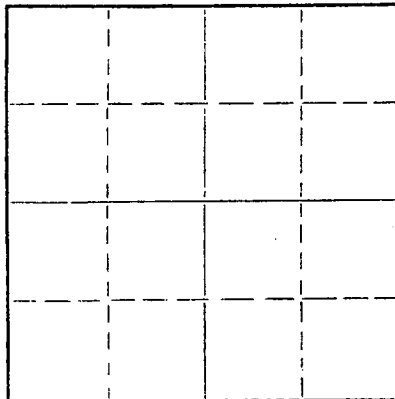

Locate well correctly on above
Section Plat

If a producing well is abandoned, date of last production _____ 19____
Was permission obtained from the Conservation Division or its agents before plugging was com-
menced? yes

Name of Conservation Agent who supervised plugging of this well Leo Massey
Producing formation _____ Depth to top _____ Bottom _____ Total Depth of Well 3425 Feet
Show depth and thickness of all water, oil and gas formations.

OIL, GAS OR WATER RECORDS

CASING RECORD

FORMATION	CONTENT	FROM	TO	SIZE	PUT IN	PULLED OUT
				8-5/8"	816'	None
				5-1/2"	3413'	None

Describe in detail the manner in which the well was plugged, indicating where the mud fluid was placed and the method or methods used in introducing it into the hole. If cement or other plugs were used, state the character of same and depth placed, from _____ feet to _____ feet for each plug set.

Checked hole to 3425', sanded hole to 3390' and
dumped 5 sacks of cement @ 3390' with dump bailer.
Pumped 20 sacks of gel mud and 125 sacks of cement
to cap well.

RECEIVED
OCT 11 1966
CONSERVATION DIVISION
WICHITA, KANSAS
10-11-66

PLUGGING COMPLETE.

(If additional description is necessary, use BACK of this sheet)

Name of Plugging Contractor KNIGHT CASING PULLING COMPANY
Address CHASE, KANSAS

STATE OF KANSAS, COUNTY OF RICE, ss.
Noel J. Knight (employee of owner) or (owner or operator) of the above-described
well, being first duly sworn on oath, says: That I have knowledge of the facts, statements, and matters herein contained and the log of the
above-described well as filed and that the same are true and correct. So help me God.

(Signature) Noel J. Knight
Chase, Kansas
(Address)

SUBSCRIBED AND SWORN TO before me this 7th day of October, 19 66


My commission expires May 20, 1968 Milton J. Volin Notary Public.

Company- LEE PHILLIPS OIL CO.
 Farm- Gumble No. 4

SEC. 8 T. 11 R. 17W
 NE SW NW

Total Depth. 3425
 Comm. 9-5-51 Comp. 11-7-51
 Shot or Treated.
 Contractor. Peel Brothers, Inc.
 Issued. 12-8-51

County Ellis
 KANSAS

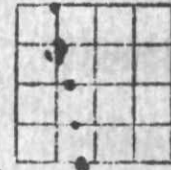

Elevation 1866 RB

Production. 40 bbls.

Figures indicate Bottom of Formations.

clay, sand	40
sand	90
shale	200
shale, shells	370
sand	400
shale, iron	560
sand	675
red rock, shale	1070
anhydrite	1110
shale, shells	1206
sand, shale	1515
salt, shale	1590
salt, sand	1675
sharp sand	1715
salt, sand, shells	1775
shells, sand	2000
shale, sand	2070
lime, shale	2600
shale	2620
sandy lime, shale	2690
lime, shale	2965
lime	3000
lime, shale	3112
lime	3165
lime, shale	3262
lime	3335
lime, red shale	3355
lime	3357
chert lime, conglomerate	3393
conglomerate, arbutle	3414
conglomerate, arbutle	3425
Total depth	

RECEIVED
 STATE CORPORATION COMMISSION
 SEP 12 1955
 CONSERVATION DIVISION
 Wichita, Kansas

Hebner	3044
Toronto	3060
Lansing	3097
Conglomerate	3360
Simpson	3385
Arbuckle	3413

15-051-02133-00-00

500 gal. acid swab 4 BOPH

RECEIVED
