

TYPE

AFFIDAVIT OF COMPLETION FORM

CO-1 WELL HISTORY

SIDE ONE

Two (2) copies of this form shall be filed with the Kansas Corporation Commission, 200 Colorado Derby Building, Wichita, Kansas 67202, within thirty (30) days after the completion of a well, regardless of how the well was completed.

Attach separate letter of request if the information is to be held confidential. If confidential, only file one copy. Information on Side One will be of public record and Side Two will then be held confidential.

Applications must be made on dual completion, commingling, salt water disposal, injection and temporarily abandoned wells.

Attach one copy only wireline logs (i.e. electrical log, sonic log, gamma ray neutron log, etc.). (Rules 82-2-105 & 82-2-125) KCC# (316) 263-3238.

LICENSE # 5465 EXPIRATION DATE 6-30-83

OPERATOR Collins & Collins Oil Co. API NO. 15-051-23,260.-0000

ADDRESS 1007 Cody, Ste A, COUNTY Ellis

Hays, Ks. 67601. FIELD

\*\* CONTACT PERSON Gloria Brown PROD. FORMATION
PHONE 913-628-1046

PURCHASER LEASE Jack Powell

ADDRESS WELL NO. 1


DRILLING Red Tiger Drilling Company, 930 Ft. from South Line and

CONTRACTOR ADDRESS Ste 1720, Kansas State Bank Bldg, 330 Ft. from West Line of

Wichita, Ks. 67202. the SE (Qtr.) SEC 24 TWP 11S RGE 16W.

PLUGGING WELL PLAT (Office Use Only)

CONTRACTOR ADDRESS

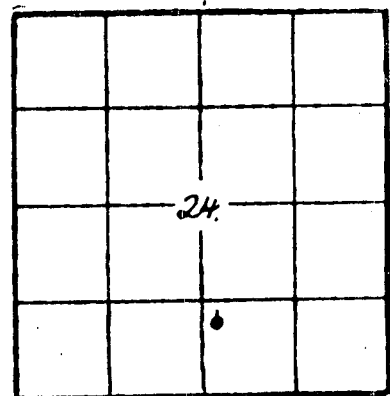

(Office Use Only)
KCC [checked]
KGS [checked]
SWD/REP
PLG.

TOTAL DEPTH 3325' PBTD

SPUD DATE 11-23-82 DATE COMPLETED

ELEV: GR DF KB 1765'

DRILLED WITH (CABLE) (ROTARY) (TOOLS).

DOCKET NO. OF DISPOSAL OR REPRESSURING WELL BEING USED TO DISPOSE OF WATER FROM THIS LEASE

Amount of surface pipe set and cemented 201' DV Tool Used?

THIS AFFIDAVIT APPLIES TO: (Circle ONE) Oil, Gas, Shut-in Gas, Dry, Disposal, Injection, Temporarily Abandoned, OWWO. Other

ALL REQUIREMENTS OF THE STATUTES, RULES AND REGULATIONS PROMULGATED TO REGULATE THE OIL AND GAS INDUSTRY HAVE BEEN FULLY COMPLIED WITH.


A F F I D A V I T

John B. Collins, being of lawful age, hereby certifies that:

I am the Affiant, and I am familiar with the contents of the foregoing Affidavit. The statements and allegations contained therein are true and correct.

Signature of John B. Collins (Name)

SUBSCRIBED AND SWORN TO BEFORE ME this 22 day of February, 19 83.

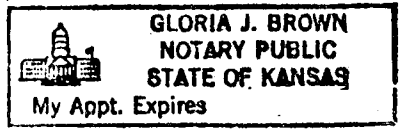

Signature of Notary Public (NOTARY PUBLIC)

MY COMMISSION EXPIRES: 7-15-84

RECEIVED STATE CORPORATION COMMISSION FEB 24 1983 CONSERVATION DIVISION Wichita, Kansas

\*\* The person who can be reached by phone regarding any questions concerning this information.

OPERATOR Collins & Collins LEASE Jack Powell #1 SEC. 24 TWP. 11S RGE. 16W

FILL IN WELL LOG AS REQUIRED:

Show all important zones of porosity and contents thereof; cored intervals, and all drill-stem tests, including depth interval tested, cushion used, time tool open, flowing and shut-in pressures, and recoveries.			SHOW GEOLOGICAL MARKERS, LOGS RUN, OR OTHER DESCRIPTIVE INFORMATION.	
FORMATION DESCRIPTION, CONTENTS, ETC.	TOP	BOTTOM	NAME	DEPTH
Sand	-0-	50		
Shale	50	322		
Sand	322	385		
Shale	385	485		
Sand & Shale	485	920		
Anhydrite	920	959		
Shale	959	2135		
Lime & Shale	2135	2380		
Shale	2380	2775		
Lime & Shale	2775	3025		
Lime	3025	3325		
RTD		3325.		

Report of all strings set— surface, intermediate, production, etc. CASING RECORD (New) or ~~(Used)~~

Purpose of string	Size hole drilled	Size casing set (in O.D.)	Weight lbs/ft.	Setting depth	Type cement	Sacks	Type and percent additives
Surface	12 $\frac{3}{4}$ "	8-5/8"	24 $\frac{1}{2}$ lb	208'	Common	150	2% gel, 3% cc.
Production	7-7/8"	5 $\frac{1}{2}$ "	14 lb	3325'	Common	140	8% salt, 4% gel, 2% g

LINER RECORD

PERFORATION RECORD

Top, ft.	Bottom, ft.	Sacks cement	Shots per ft.	Size & type	Depth interval

TUBING RECORD		
Size	Setting depth	Packer set at

ACID, FRACTURE, SHOT, CEMENT SQUEEZE RECORD

Amount and kind of material used	Depth interval treated

Date of first production	Producing method (flowing, pumping, gas lift, etc.)	Gravity
RATE OF PRODUCTION PER 24 HOURS	Oil bbls.	Gas MCF
	Water %	Gas-oil ratio bbls. CFPB
Disposition of gas (vented, used on lease or sold)		Perforations