


STATE OF KANSAS
STATE CORPORATION COMMISSION

Give All Information Completely
Make Required Affidavit
Mail or Deliver Report to:
Conservation Division
State Corporation Commission
211 No. Broadway
Wichita, Kansas

WELL PLUGGING RECORD

Ellis County, Sec. 35 Twp. 11 Rge. (E) 16 (W)
Location as "NE/CNW/SW" or footage from lines NE NE SW
Lease Owner Louis M. Mai Operations
Lease Name Chrisler A-1 Well No. 1
Office Address Box 33 Russell, Kansas
Character of Well (completed as Oil, Gas or Dry Hole) Dry Hole
Date well completed October 25 19 63
Application for plugging filed October 25 19 63
Application for plugging approved October 25 19 63
Plugging commenced October 25 19 63
Plugging completed October 25 19 63
Reason for abandonment of well or producing formation Dry Hole

NORTH

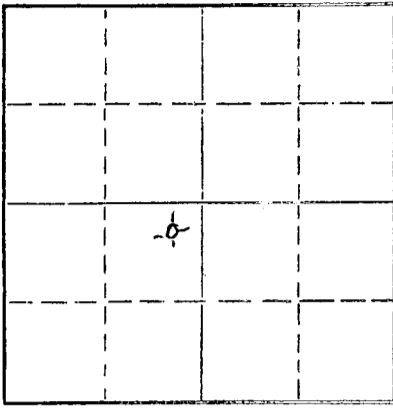

Locate well correctly on above
Section Plat

If a producing well is abandoned, date of last production 19
Was permission obtained from the Conservation Division or its agents before plugging was commenced? Yes

Name of Conservation Agent who supervised plugging of this well Don Truan
Producing formation _____ Depth to top _____ Bottom _____ Total Depth of Well 3377 Feet
Show depth and thickness of all water, oil and gas formations.

OIL, GAS OR WATER RECORDS

CASING RECORD

FORMATION	CONTENT	FROM	TO	SIZE	PUT IN	PULLED OUT
				8 5/8"	245'	None

Describe in detail the manner in which the well was plugged, indicating where the mud fluid was placed and the method or methods used in introducing it into the hole. If cement or other plugs were used, state the character of same and depth placed, from _____ feet to _____ feet for each plug set.
Fill hole to 600' with heavy mud. Pumped plug to 600' and squeezed with 100 sacks of cement to surface.

RECEIVED
STATE CORPORATION COMMISSION
NOV 5 1963
11-5-1963
CONSERVATION DIVISION
Wichita, Kansas

(If additional description is necessary, use BACK of this sheet)
Name of Plugging Contractor Mast Drilling, Inc.
Address Box 33 Russell, Kansas

STATE OF KANSAS, COUNTY OF RUSSELL, ss.
Louis M. Mai (employee of owner) or (owner) of the above-described well, being first duly sworn on oath, says: That I have knowledge of the facts, statements, and matters herein contained and the log of the above-described well as filed and that the same are true and correct. So help me God.
(Signature) Louis M. Mai
Box 33 Russell, Kansas (Address)

SUBSCRIBED AND SWORN TO before me this 4th day of November, 19 63
My commission expires January 8, 1966
Beverly Haynes Notary Public.

