


STATE OF KANSAS
STATE CORPORATION COMMISSION
200 Colorado Derby Bldg.
Wichita, Kansas 67202

WELL PLUGGING RECORD

Give All Information Completely
Make Required Affidavit

COUNTY Ellis SEC. 35 TWP. 11S RGE. 16W E/V
Location as in quarters or footage from lines:
50' N of SE/4 SE/4 SW/4

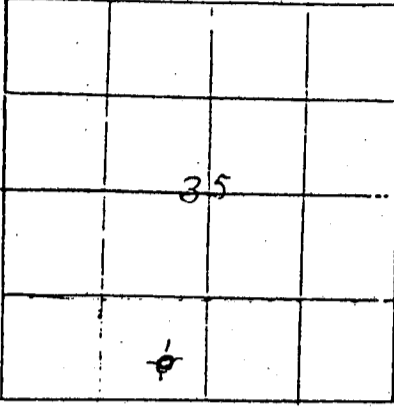

Lease Owner Ernst & Steinle Oil Operations
Lease Name Chrisler Well No. 2
Office Address 1025 Main, Box 859, Russell, Kansas 67665
Character of Well (Completed as Oil, Gas or Dry Hole): Dry Hole
Date Well Completed August 14, 1983
Application for plugging filed August 14, 1983
Plugging commenced August 14, 1983
Plugging completed August 14, 1983
Reason for abandonment of well or producing formation D & A

Locate Well
correctly on above
Section Plat.

Was permission obtained from the Conservation Division or it's
Agent's before plugging was commenced? Yes

Name of Conservation Agent who supervised plugging of this well Carl Skidrow

Producing formation _____ Depth to top _____ bottom _____ T.D. 3,337'

Show depth and thickness of all water, oil and gas formations.

OIL, GAS OR WATER RECORDS Casing Record

Formation	Content	From	To	Size	Put in	Pulled Out
				8 5/8"	242.98'	-0-

Describe in detail the manner in which the well was plugged, indicating where the mud
fluid was placed and the method or methods used in introducing it into the hold. If cement
or other plugs were used, state the character of same and depth placed, from _____ feet
to _____ feet for each plug set.

Hole Plugged w/20 sx cement @ 910'
90 sx cement @ 600'
40 sx cement @ 250'
Bridge @ 40' w/10 sx cement to surface
10 sx cement in rathole
50/50 Pozmix, 4% Gel, 3% C.C.

(If additional description is necessary, use BACK of this sheet)
Name of Plugging Contractor Sun Oil Well Cementing

STATE OF KANSAS COUNTY OF RUSSELL, ss.
Fred Ernst (employee of owner) or (owner or operator) of the
above-described well, being first duly sworn on oath, says: That I have knowledge of the
facts, statements, and matters herein contained and the log of the above-described well as
filed and that the same are true and correct. So help me God.

(Signature) Fred Ernst
Russell, Ks. 67665
(Address)

SUBSCRIBED AND SWORN TO before me this 23rd day of August, 19 83

My Commission expires:



RECEIVED
9-19-1983
SEP 19 1983
Notary Public.