

15-051-20345-00-00


STATE OF KANSAS  
STATE CORPORATION COMMISSION

Form CP-4

WELL PLUGGING RECORD

Give All Information Completely  
Make Required Affidavit  
Mail or Deliver Report to:  
Conservation Division  
State Corporation Commission  
212 No. Market  
Wichita, Kansas

NORTH

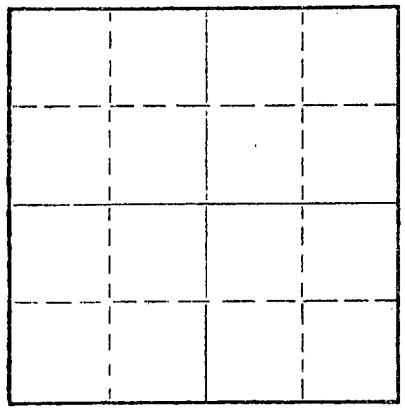

Locate well correctly on above  
Section Plat

Ellis County. Sec. 1 Twp. 11S Rge. (E) 17(W)

Location as "NE/CNW/SW" or footage from lines C SE SE NE

Lease Owner Three G Oil, Inc.

Lease Name Dreiling Well No. 1

Office Address 1101 Wichita Plaza Bldg., Wichita, Kansas

Character of Well (completed as Oil, Gas or Dry Hole) Dry Hole

Date well completed November 6 1968

Application for plugging filed Verbal Approval 1968

Application for plugging approved Verbal Approval 1968

Plugging commenced November 6 1968

Plugging completed November 6 1968

Reason for abandonment of well or producing formation \_\_\_\_\_

If a producing well is abandoned, date of last production \_\_\_\_\_ 1968

Was permission obtained from the Conservation Division or its agents before plugging was commenced? Yes

Name of Conservation Agent who supervised plugging of this well Leo F. Massey

Producing formation \_\_\_\_\_ Depth to top \_\_\_\_\_ Bottom \_\_\_\_\_ Total Depth of Well \_\_\_\_\_ Feet

Show depth and thickness of all water, oil and gas formations.

OIL, GAS OR WATER RECORDS

CASING RECORD

FORMATION	CONTENT	STATE	SIZE	PUT IN	PULLED OUT
			8-5/8"	249'	None

Describe in detail the manner in which the well was plugged, indicating where the mud fluid was placed and the method or methods used in introducing it into the hole. If cement or other plugs were used, state the character of same and depth placed, from \_\_\_\_\_ feet to \_\_\_\_\_ feet for each plug set.

Filled hole with heavy rotary mud from 3,443 feet (rotary total depth. Squeezed through 8-5/8" swage nipple with 130 sacks cement by Sun Oilwell Cementing Company pump truck, 2 sacks cement in rathole.

(If additional description is necessary, use BACK of this sheet)

Name of Plugging Contractor H-30, INC.  
Address 200 N. Main St., Wichita, Kansas 67202

STATE OF KANSAS, COUNTY OF SEDGWICK, ss. Arlo B. Romer

(employee of owner) or (owner or operator) of the above-described well, being first duly sworn on oath, says: That I have knowledge of the facts, statements, and matters herein contained and the log of the above-described well as filed and that the same are true and correct. So help me God.


(Signature) Arlo B. Romer  
200 N. Main St., Wichita, Kansas 67202

(Address)

SUBSCRIBED AND SWORN to before me this 8th day of November, 1968

Martha Hartpence  
Martha Hartpence Notary Public.

My commission expires April 21, 1971

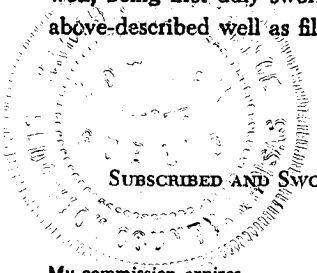

15-051-20345-00-00  
**KANSAS GEOLOGICAL SOCIETY**  
 KANSAS WELL LOG BUREAU - KANSAS WELL SAMPLE BUREAU  
 KANSAS GEOLOGICAL SOCIETY BUILDING  
 508 EAST MURDOCK - WICHITA, KANSAS

COMPANY Three G Oil, Inc.

SEC. 1 T. 11S. 17W  
 LOC. C SE SE NE

FARM Dreiling NO. 1

TOTAL DEPTH 3,443'  
 COMM. October 28, 1968  
 SHOT OR TREATED  
 CONTRACTOR H-30, INC.  
 ISSUED

COMP. November 6, 1968

COUNTY Ellis  
 KANSAS

**RECEIVED**  
 STATE CORPORATION COMMISSION  
 NOV 12 1968  
 CONSERVATION DIVISION  
 Wichita, Kansas


CASING

20	10		
15	8	-5/8" 249' cemented w/160 sx cement	ELEVATION 1837 KB
12	6		
13	5		

PRODUCTION

FIGURES INDICATE BOTTOM OF FORMATIONS

Surface Clay & Post Rock	70			<u>ELECTRIC LOG TOPS</u>
Shale	110			
Shale & Hard Sand	250	Anhydrite	1023 + 814	
Shale	390	Anhydrite Base	1058 + 779	
Sand	510	Topeka	2751 - 914	
Shale & Sand	690	Heebner	2982 -1145	
Red Bed	1025	Toronto	3004 -1167	
Anhydrite	1060	Lansing	3025 -1188	
Shale	1275	Base K.C.	3267 -1430	
Shale & Anhydrite Streaks	1380	Pleasanton Sand	3270 -1433	
Salt	1580	Marmaton	3297 -1460	
Shale	1635	Conglomerate	3370 -1533	
Shale & Shells	1800	Simpson Dolomite	3405 -1568	
Shale & Lime	2753	Arbuckle	3432 -1595	
Lime	3272	Log TD	3442 -1605	
Sand	3298	Rotary TD	3443 -1606	
Shale & Lime	3405			
Lime	3443			
Rotary Total Depth	3443			

I hereby certify the above and foregoing to be a true and correct log of the above described well as shown by the drilling reports.

H-30, INC.

Arlo B. Romer  
 Arlo B. Romer

STATE OF KANSAS }  
 COUNTY OF SEDGWICK } SS:

Subscribed and Sworn to before me a Notary Public in and for said county and state this 8th day of November, 1968.

Martha Hartpence  
 Martha Hartpence Notary Public

My Commission Expires:

April 21, 1971