

STATE OF KANSAS  
STATE CORPORATION COMMISSION

Form CP-4


Give All Information Completely  
Make Required Affidavit  
Mail or Deliver Report to:  
Conservation Division  
State Corporation Commission  
212 No. Market  
Wichita, Kansas

WELL PLUGGING RECORD

Ellis County, Sec. 1 Twp. 11S Rge. (E) 17 (W)

Location as "NE/CNW%SW%" or footage from lines NE SE  
Lease Owner Abercrombie Drilling, Inc.  
Lease Name BEFORT Well No. 1  
Office Address 801 Union Center; Wichita, Kansas  
Character of Well (completed as Oil, Gas or Dry Hole) Dry Hole  
Date well completed July 1, 19 67  
Application for plugging filed (verbally) July 1, 19 67  
Application for plugging approved (verbally) July 1, 19 67  
Plugging commenced July 1, 19 67  
Plugging completed July 1, 19 67  
Reason for abandonment of well or producing formation Dry Hole

NORTH

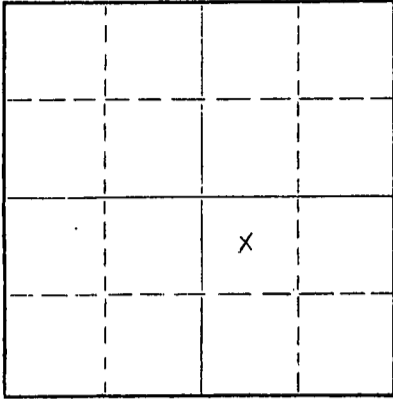

Locate well correctly on above  
Section Plat

If a producing well is abandoned, date of last production \_\_\_\_\_ 19\_\_\_\_  
Was permission obtained from the Conservation Division or its agents before plugging was commenced? Yes

Name of Conservation Agent who supervised plugging of this well Bill Nichols  
Producing formation \_\_\_\_\_ Depth to top \_\_\_\_\_ Bottom \_\_\_\_\_ Total Depth of Well 3485 Feet  
Show depth and thickness of all water, oil and gas formations.

OIL, GAS OR WATER RECORDS

CASING RECORD

FORMATION	CONTENT	FROM	TO	SIZE	PUT IN	PULLED OUT
				7"	243'	None

Describe in detail the manner in which the well was plugged, indicating where the mud fluid was placed and the method or methods used in introducing it into the hole. If cement or other plugs were used, state the character of same and depth placed, from \_\_\_\_\_ feet to \_\_\_\_\_ feet for each plug set.

First plug @ 540' with 15 sx. cement  
Second plug @ 250' with 15 sx. cement  
Top plug @ 40' with 10 sx. cement

RECEIVED  
STATE CORPORATION COMMISSION  
7-11-1967  
JUL 11 1967  
CONSERVATION DIVISION  
Wichita, Kansas

(If additional description is necessary, use BACK of this sheet)

Name of Plugging Contractor Abercrombie Drilling, Inc.  
Address West Tenth Street; Great Bend, Kansas

STATE OF KANSAS, COUNTY OF SEDGWICK, ss.  
Jerry A. Langrehr (employee of owner) or (owner or operator) of the above-described well, being first duly sworn on oath, says: That I have knowledge of the facts, statements, and matters herein contained and the log of the above-described well as filed and that the same are true and correct. So help me God.

(Signature) Jerry A. Langrehr  
Jerry A. Langrehr  
801 Union Center; Wichita, Kansas  
(Address)

SUBSCRIBED AND SWORN TO before me this fifth day of July, 19 67

My commission expires March 31, 1970

Margo Dee Montgomery  
Margo Dee Montgomery Notary Public.

CONTRACTOR'S WELL LOG

COMPANY: Abercrombie Drilling, Inc.  
 CONTRACTOR: Abercrombie Drilling, Inc.  
 FARM: BEFORT #1  
 LOCATION: NE SE, Sec. 1-11S-17W  
 Ellis County, Kansas  
 COMMENCED: June 24, 1967  
 COMPLETED: July 1, 1967

0	350	Shale
350	509	Sand
509	1042	Shale
1042	1076	Anhydrite
1076	1635	Shale
1635	2774	Lime & Shale
2774	2940	Lime
2940	3045	Lime & Shale
3045	3215	Lime
3215	3309	Lime & Shale
3309	3441	Cong. Shale & Chert
3441	3485	Arbuckle Dolomite
	3485	Rotary Total Depth

Set 7", 26#, surface casing @ 243' with 145 sacks of cement.  
 Dry and Abandoned.

ELECTRIC LOG TOPS:

ELEVATION:

Anhydrite	1035	(+ 815)	1850	K. B.
Heebner	3000	(-1150)	1849	D. F.
Toronto	3020	(-1170)	1843	G. L.
Lansing	3041	(-1191)		
B/Kansas City	3286	(-1436)		
Marmaton Lmst.	3314	(-1464)		
Marmaton Chert	3325	(-1475)		
Arbuckle	3441	(-1591)		
Log T. D.	3483	(-1633)		

RECEIVED  
 STATE CORPORATION COMMISSION  
 7-11-1967  
 JUL 11 1967

STATE OF KANSAS )  
 ) SS  
 COUNTY OF SEDGWICK )

CONSERVATION DIVISION  
 Wichita, Kansas

I, Jerry A. Langrehr, do hereby certify that the above and foregoing is a true and correct copy of the log of the BEFORT #1, NE SE of Section 1-11S-17W, Ellis County, Kansas, as reflected by the files of Abercrombie Drilling, Inc.

*Jerry A. Langrehr*  
 Jerry A. Langrehr  
 Vice President - Exploration

Subscribed and sworn to before me, a Notary Public, in and for Sedgwick County, Kansas, this 10th day of July, 1967.

*Margo Dee Montgomery*  
 Margo Dee Montgomery  
 Notary Public

My Commission Expires:  
 March 31, 1970