


STATE OF KANSAS  
STATE CORPORATION COMMISSION

15-051-21976-00-00  
WELL PLUGGING RECORD

Give All Information Completely  
Make Required Affidavit  
Mail or Deliver Report to  
Conservation Division  
State Corporation Comm.  
245 North Water  
Wichita, KS 67202

ELLIS County, Sec. 1 Twp. 11 Rge. 17 E/W  
Location as "NE/CNW $\frac{1}{4}$ SW $\frac{1}{4}$ " or footage from lines \_\_\_\_\_  
SE SW NE  
Lease Owner Icer Addis  
Lease Name DREILING Well No. 1  
Office Address P.O. Drawer 8038 - Wichita, Ks. 67208  
Character of Well (Completed as Oil, Gas or Dry Hole) \_\_\_\_\_  
Dry Hole

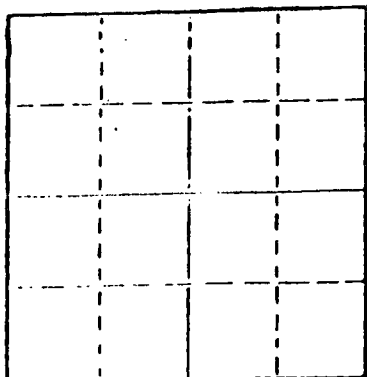

Locate well correctly on above  
Section Plot

Date Well completed July 18, 19 80  
Application for plugging filed July 18 19 80  
Application for plugging approved July 18 19 80  
Plugging commenced July 18 19 80  
Plugging completed July 18 19 80  
Reason for abandonment of well or producing formation \_\_\_\_\_

If a producing well is abandoned, date of last production \_\_\_\_\_ 19 \_\_\_\_\_

Was permission obtained from the Conservation Division or its agents before plugging was commenced? yes

Name of Conservation Agent who supervised plugging of this well Marion Schmidt  
Producing formation \_\_\_\_\_ Depth to top \_\_\_\_\_ Bottom \_\_\_\_\_ Total Depth of Well 3525  
Show depth and thickness of all water, oil and gas formations.

OIL, GAS OR WATER RECORDS

CASING RECORD

FORMATION	CONTENT	FROM	TO	SIZE	PUT IN	PULLED OUT

Describe in detail the manner in which the well was plugged, indicating where the mud fluid was placed and the method or methods used in introducing it into the hold. If cement or other plugs were used, state the character of same and depth placed, from \_\_\_\_\_ feet to \_\_\_\_\_ feet for each plug set.

Bottom plug @ 680' w/70 sacks 50/50 pozmix, 6% Gel thru drill pipe

Middle plug @ 240' w/25 sacks " " " "

Top plug @ 40' w/solid bridge and  $\frac{1}{2}$  sacks hulls with 10 sacks cement ~~XX~~.

5 sacks cement in rat hole.

(If additional description is necessary, use BACK of this sheet)

Name of Plugging Contractor Duke Drilling Co., Inc

STATE OF Kansas COUNTY OF Barton  
Bill Draney (employee of owner) or owner/operater

of the above-described well, being first duly sworn on oath, says: That I have known of the facts, statements, and matters herein contained and the log of the above-described well as filed and that the same are true and correct. So help me God.


(Signature) Bill Draney

Box 823, Great Bend, Ks. 67530  
(Address)

SUBSCRIBED AND SWORN TO before me this 21 day of July, 19 80

My commission expires April 11, 1982

Deborah M. Wague  
Notary Public.

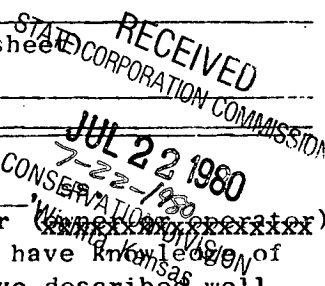

DRILLER'S WELL LOG

DATE COMMENCED: July 11, 1980  
DATE COMPLETED: July 18, 1980

Icer Addis  
DREILING #1  
Sec.1, T11, R17S  
Ellis County, Ks.

0 - 254'	Surface Soil & Blue Shale
254 - 550'	Shale, Red Bed, Hard Sand
550 - 554'	Hard Sand
554 - 649'	Shale
649 - 744'	Sand
744 - 1086'	Shale, Streaks/Sand
1086 - 1135'	Anhydrite
1135 - 2821'	Shale & Lime Stks.
2821 - 3052'	Lime
3052 - 3056'	Shale
3056 - 3093'	Lime & Shale
3093 - 3334'	Lime
3334 - 3458'	Lime, Shale, Chert
3458 - 3525'	Shale, Dolomite
3525'	RTD

ELEVATION: 1896 K.B.

FORMATION DATA

Hard Sand	535'
Anhydrite	1086'
Topeka	2821'
Heebner	3052'
Toronto	3071'
Lensing	3093'
Base K.C.	3334'
Marmaton	3362'
Conglomerate	3388'
Simpson	3458'
Simpson Dolomite	3462'
Arbuckle	3488'
RTD	3525'

Surface Pipe: Set used 28#,  
8-5/8" pipe at 254' w/165  
sacks 50/50 potmix, 2% gel,  
3% cc.

A F F I D A V I T

STATE OF KANSAS  
COUNTY OF BARTON) ss

Bill Draney of lawful age, does swear and state that the facts and  
statements herein contained are true and correct to the best of his knowledge.

Bill Draney

Subscribed and sworn to before me this 21st day of July 1980.

My Comm. Expires:

4-11-1982

Quincy M. Brague  
Notary Public

RECEIVED  
STATE CORPORATION COMMISSION  
7-22-1980  
JUL 23 1980  
CONSERVATION DIVISION  
Wichita, Kansas