


STATE OF KANSAS
STATE CORPORATION COMMISSION

15-051-01213-00-00
WELL PLUGGING RECORD

Give All Information Completely
Make Required Affidavit
Mail or Deliver Report to:
Conservation Division
State Corporation Commission
211 No. Broadway
Wichita, Kansas

Ellis County, Sec. 1 Twp. 11 Rge. 17 (E) W (W)
Location as "NE/CNW/SW" or footage from lines NW SW SE SW *et alio*
Lease Owner Harms-Burt Drilling Company
Lease Name Hubbard Well No. 1
Office Address P. O. Box 184, Great Bend, Kansas
Character of Well (completed as Oil, Gas or Dry Hole) Dry Hole
Date well completed December 24, 1958
Application for plugging filed " 24, 1958
Application for plugging approved " 24, (verbally) 1958
Plugging commenced " 24, 1958
Plugging completed " 24, 1958
Reason for abandonment of well or producing formation Dry hole

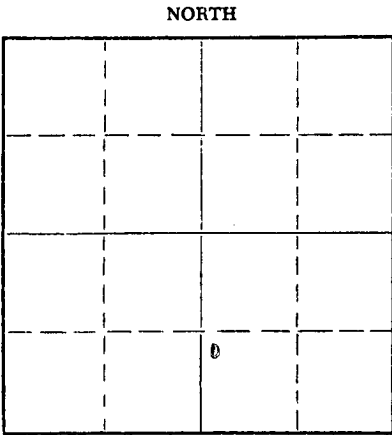

Locate well correctly on above Section Plat

If a producing well is abandoned, date of last production 19
Was permission obtained from the Conservation Division or its agents before plugging was commenced? Yes

Name of Conservation Agent who supervised plugging of this well Eldon Petty
Producing formation _____ Depth to top _____ Bottom _____ Total Depth of Well 3520 Feet
Show depth and thickness of all water, oil and gas formations.

OIL, GAS OR WATER RECORDS

CASING RECORD

FORMATION	CONTENT	FROM	TO	SIZE	PUT IN	PULLED OUT
surface		0	202'	8 5/8	202'	None

Describe in detail the manner in which the well was plugged, indicating where the mud fluid was placed and the method or methods used in introducing it into the hole. If cement or other plugs were used, state the character of same and depth placed, from _____ feet to _____ feet for each plug set.

Filled hole with heavy mud from total depth to 400' with plug and 20 sacks of cement at this point. Filled with heavy mud to 180' with plug and 15 sacks of cement. Filled with heavy mud to 40' with plug and 10 sacks of cement.

RECEIVED
STATE CORPORATION COMMISSION
FEB 24 1959
CONSERVATION DIVISION
Wichita, Kansas

Name of Plugging Contractor Harms-Burt Drilling Company
Address P. O. Box 184, Great Bend, Kansas

STATE OF Kansas, COUNTY OF Barton, ss.
Allan Harms (employee of owner) or (owner or operator) of the above-described well, being first duly sworn on oath, says: That I have knowledge of the facts, statements, and matters herein contained and the log of the above-described well as filed and that the same are true and correct. So help me God.

(Signature) *Allan Harms*
P. O. Box 184, Great Bend, Kansas (Address)

SUBSCRIBED AND SWORN TO before me this 31 day of December, 1958

Mary E. Van Pelt
Notary Public.

My commission expires January 20, 1962

PLUGGING
FILE SEC. 1 T. 11 R. 17W
BOOK PAGE 8 LINE 4

DRILLERS LOG

Company: Harms-Burt Drilling Company
Farm: Hubbard #1
Commenced: December 13, 1958

NW SW SE, Section 1-11-17W
Ellis County, Kansas
Completed: December 24, 1958

Elevation: 1890 KB

0 - 202	shale
202 - 425	shale & sand
425 - 520	sand
520 - 740	shale, pyrite, & shells
740 - 825	sand-shale
825 - 1115	red bed
1115 - 1150	anhydrite
1150 - 1500	shale & shells
1500 - 1730	shale & lime
1730 - 2170	lime
2170 - 2715	lime & shale
2715 - 2850	shale & lime
2850 - 2925	lime & shale
2925 - 3061	lime
3061 - 3066	Heebner
3066 - 3105	lime-shale
3105 - 3342	lime
3342 - 3372	lime & shale
3372 - 3453	conglomerate
3453 - 3493	lime-shale
3493 - 3520	Arbuckle
3520	total depth

Set 202' 8 5/8" surface pipe. Cemented with 175 sacks of cement.

Tops:

Anhydrite	-	+785
Heebner	-	(-1171)
Lansing	-	(-1215)
Base K.D.	-	(-1452)
Cong.	-	(-1482)
Arbuckle	-	(-1603)

Dry, plugged and abandoned.

A F F I D A V I T

State of Kansas)
)SS.
County of Barton)

I, Allan Harms of the Harms-Burt Drilling Company being first duly sworn on oath state: I have knowledge of the facts, statements and matters herein contained and the same are true and correct.

Allan Harms

Subscribed and sworn to before me this 31 day of December 1958.

My commission expires January 20, 1962.

Mary E. Van Pelt
Notary Public

RECEIVED
STATE COMMISSION
FEB 24 1959
CONSERVATION DIVISION
Wichita, Kansas

PLUGGING
FILE SEC. 1 T. 11 R. 17W
BOOK PAGE 0 LINE 41