


Give All Information Completely
Make Required Affidavit
Mail or Deliver Report to:
Conservation Division
State Corporation Commission
212 North Market, Insurance Bldg.
Wichita, Kansas

15-051-01320-0000
WELL PLUGGING RECORD

ELLIS County. Sec. 28 Twp. 11S Rge. (E) 16 (W)

Location as "NE/CNW%SW%" or footage from lines SE NE NE
Lease Owner MORRISON PRODUCING COMPANY
Lease Name Mc GUIRE Well No. 2
Office Address P. O. DRAWER 712, EL DORADO, KANSAS
Character of Well (completed as Oil, Gas or Dry Hole) DRY HOLE
Date well completed 25 APRIL 19 61
Application for plugging filed 25 APRIL 19 61
Application for plugging approved 25 APRIL 19 61
Plugging commenced 25 APRIL 19 61
Plugging completed 25 APRIL 19 61
Reason for abandonment of well or producing formation DRY HOLE

NORTH

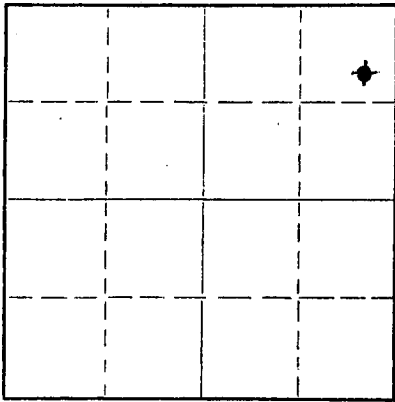

Locate well correctly on above Section Plat

If a producing well is abandoned, date of last production NONE 19
Was permission obtained from the Conservation Division or its agents before plugging was commenced? YES

Name of Conservation Agent who supervised plugging of this well ELDEN PETTY
Producing formation NONE Depth to top _____ Bottom _____ Total Depth of Well 3380 RB Feet
Show depth and thickness of all water, oil and gas formations.

OIL, GAS OR WATER RECORDS

CASING RECORD

FORMATION	CONTENT	FROM	TO	SIZE	PUT IN	PULLED OUT
<u>SURFACE HOLE</u>	<u>WATER</u>	<u>SURFACE</u>	<u>970' RB</u>	<u>8 5/8" OD</u>	<u>965'</u>	<u>LEFT IN</u>
<u>(SEE ATTACHED LOG)</u>						

Describe in detail the manner in which the well was plugged, indicating where the mud fluid was placed and the method or methods used in introducing it into the hole. If cement or other plugs were used, state the character of same and depth placed, from _____ feet to _____ feet for each plug set.

FILLED HOLE WITH DRILLING MUD TO 400', SET PLUG AND CEMENTED WITH 20 SACKS CEMENT, FILLED HOLE WITH DRILLING MUD TO 200', SET PLUG AND CEMENTED WITH 20 SACKS CEMENT, FILLED HOLE WITH DRILLING MUD TO 40', SET PLUG AND CEMENTED WITH 10 SACKS CEMENT, TO SURFACE.

RECEIVED
STATE CORPORATION COMMISSION
MAY 3 1961
CONSERVATION DIVISION
Wichita, Kansas

(If additional description is necessary, use BACK of this sheet)
Name of Plugging Contractor REX & MORRIS DRILLING COMPANY
Address P. O. BOX 334, EL DORADO, KANSAS


STATE OF KANSAS, COUNTY OF BUTLER, ss. A. H. FISHER

(employee of owner) or (owner or operator) of the above-described well, being first duly sworn on oath, says: That I have knowledge of the facts, statements, and matters herein contained and the log of the above-described well as filed and that the same are true and correct. So help me God.

(Signature) A. H. Fisher
P. O. BOX 334, EL DORADO, KANSAS
(Address)

SUBSCRIBED AND SWORN TO before me this 1ST day of MAY, 19 61

My commission expires 8 AUGUST 1962
Elizabeth Deschner
ELIZABETH DESCHNER Notary Public.

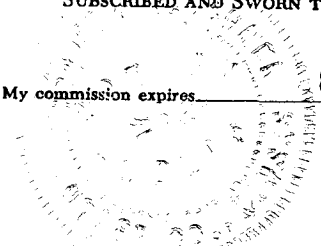

15-051-01320-0000

Elevation 1798 R. B.
1795 D. F.

MC GUIRE #2

Morrison Producing Company

Total Depth: 3380
Contractor: Rex & Morris Drilling Co.
Commenced: 4-16-61
Completed: 4-25-61
Initial Production: D. & A.

Location: SE NE NE
Section 28-11S-16W
Ellis County, Kansas
Casing Record:
8 5/8 @ 970' w/475 sacks

FORMATION	DEPTH
Surface Hole	970
Lime (Anhydrite)	1002
Shale and Salt	1500
Shale and Lime	1815
Lime and Shale	2760
Lime	2850
Lime and Shale	2905
Lime	3275
Shale and Lime	3351
Conglomerate	T.D. 3380

RECEIVED
STATE CORPORATIONS COMMISSION
MAY 3 1961
CONSERVATION DIVISION
TOPEKA, KANSAS

I hereby certify the foregoing statements are true and correct to the best of my knowledge and belief.

Rex & Morris Drilling Company

By Paul D. Koentz
Paul D. Koentz, Geologist

STATE OF KANSAS
COUNTY OF BUTLER, SS.

Subscribed and sworn to before me, a Notary Public, this 2nd day of May, 1961.

Elizabeth Deschner
Elizabeth Deschner, Notary Public

My commission expires: August 8, 1962.



15-051-01320-0000

77779