


STATE OF KANSAS
STATE CORPORATION COMMISSION

Give All Information Completely
Make Required Affidavit
Mail or Deliver Report to:
Conservation Division
State Corporation Commission
212 No. Market
Wichita, Kansas 67202

WELL PLUGGING RECORD

Ellis County, Sec. 28 Twp. 11 Rge. (E) 16(W)
Location as "NE/CNW&SW&" or footage from lines SW SW NW
Lease Owner Tomlinson Oil Company, Inc.
Lease Name Neilson Well No. 5
Office Address 1125 Wichita Plaza, Wichita, Kansas
Character of Well (completed as Oil, Gas or Dry Hole) oil
Date well completed _____ 19____
Application for plugging filed _____ 19____
Application for plugging approved _____ 19____
Plugging commenced January 24 1970
Plugging completed January 27 1970
Reason for abandonment of well or producing formation depleted

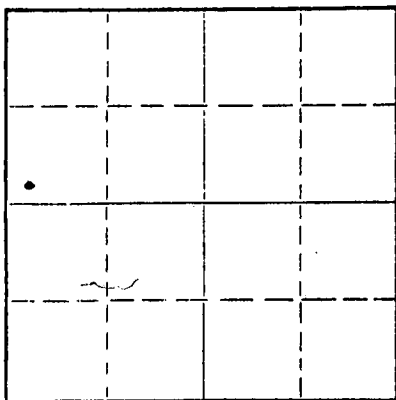

Locate well correctly on above
Section Plat

If a producing well is abandoned, date of last production _____ 19____
Was permission obtained from the Conservation Division or its agents before plugging was commenced? yes

Name of Conservation Agent who supervised plugging of this well Leo Massey
Producing formation _____ Depth to top _____ Bottom _____ Total Depth of Well 3382 Feet
Show depth and thickness of all water, oil and gas formations.

OIL, GAS OR WATER RECORDS

CASING RECORD

FORMATION	CONTENT	FROM	TO	SIZE	PUT IN	PULLED OUT
		0	945'	8 5/8"	945'	none
		0	3382'	5 1/2"	3382'	2719.51

Describe in detail the manner in which the well was plugged, indicating where the mud fluid was placed and the method or methods used in introducing it into the hole. If cement or other plugs were used, state the character of same and depth placed, from _____ feet to _____ feet for each plug set.

Sanded back to 3275' and dumped 5 sacks of cement.
Set 20' rock bridge at 450' and filled hole with 6 1/2 yards of ready mix cement.

RECEIVED
STATE CORPORATION COMMISSION
FEB 4 1970
CONSERVATION DIVISION
Wichita, Kansas

Name of Plugging Contractor PIPE PULLERS, INC.
Address Box 486, Ellinwood, Kansas

STATE OF Kansas, COUNTY OF Barton, ss.
Evelyn Roth (employee of owner) or (owner or operator) of the above-described well, being first duly sworn on oath, says: That I have knowledge of the facts, statements, and matters herein contained and the log of the above-described well as filed and that the same are true and correct. So help me God.

(Signature) Evelyn Roth
Ellinwood, Kansas (Address)

SUBSCRIBED AND SWORN TO before me this 3 day of February, 1970

My commission expires July 7, 1972

Notary Public.

15-051-02078-0000

WELL LOG BUREAU—KANSAS GEOLOGICAL SOCIETY
50S East Murdock, Wichita, Kansas


COPY

Company- TOMLINSON-KATHOL, INC.
Farm- Nielsen No. 5

SEC. 28 T. 11 R.16W
SW SW NW

Total Depth. 3375'
Comm. 5-17-59 Comp. 5-27-59
Shot or Treated.
Contractor. Tomlinson-Kathol, Inc.
Issued. 9-26-59

County Ellis
KANSAS

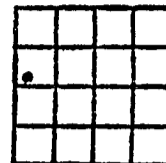

Elevation. 1761' KB

Production. 37 BOPD

Figures Indicate Bottom of Formations.

clay & post rock	38
shale, post rock	165
shale	375
sand	440
shale	480
iron	485
shale	650
red shale	707
red shale & sand	915
red shale	934
Anhydrite	1096
shale	1583
shale & lime strks	1790
lime & shale	1927
lime	2230
lime & shale	2375
shale	2822
lime	2900
lime & shale	3085
lime	3238
lime & shale	3282
Arbuckle	3375 RTD
Total Depth	

RECEIVED
STATE CONSERVATION COMMISSION
DEC 29 1969
CONSERVATION DIVISION
Wichita, Kansas

TOPS:	
Heebner	2931
Toronto	2953
Lansing	2981
Base Kansas City	3227
Arbuckle	3282