

15-051-02077-0000


STATE OF KANSAS
STATE CORPORATION COMMISSION

Form CP-4

Give All Information Completely
Make Required Affidavit
Mail or Deliver Report to:
Conservation Division
State Corporation Commission
212 No. Market
Wichita, Kansas 67202

WELL PLUGGING RECORD

NORTH

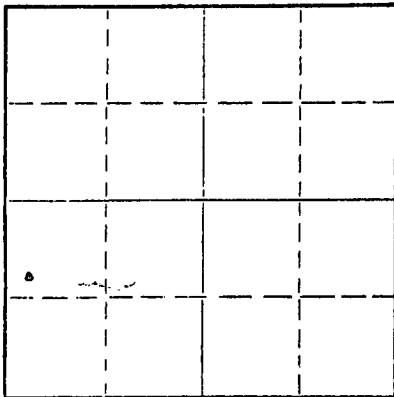

Locate well correctly on above
Section Plat

Ellis County, Sec. 28 Twp. 11 Rge. (E) 16(W)
Location as "NE/CNWxSWx" or footage from lines SW NW SW
Lease Owner Tomlinson Oil Company, Inc.
Lease Name Neilson Well No. 4
Office Address 1125 Wichita Plaza, Wichita, Kansas
Character of Well (completed as Oil, Gas or Dry Hole) oil
Date well completed _____ 19____
Application for plugging filed _____ 19____
Application for plugging approved _____ 19____
Plugging commenced January 15 1970
Plugging completed January 24 1970
Reason for abandonment of well or producing formation depleted

If a producing well is abandoned, date of last production _____ 19____
Was permission obtained from the Conservation Division or its agents before plugging was commenced? yes

Name of Conservation Agent who supervised plugging of this well Leo Massey
Producing formation _____ Depth to top _____ Bottom _____ Total Depth of Well 3410 Feet
Show depth and thickness of all water, oil and gas formations.

OIL, GAS OR WATER RECORDS

CASING RECORD

FORMATION	CONTENT	FROM	TO	SIZE	PUT IN	PULLED OUT
		0	982'	8 5/8"	982'	none
		0	3410'	5 1/2"	3410'	2748.48

Describe in detail the manner in which the well was plugged, indicating where the mud fluid was placed and the method or methods used in introducing it into the hole. If cement or other plugs were used, state the character of same and depth placed, from _____ feet to _____ feet for each plug set.

Sanded back to 3330' and dumped 5 sacks of cement.

Set 20' rock bridge at 450' and filled hole with 6 yards of ready mix cement.

RECEIVED
STATE CORPORATION COMMISSION
FEB 4 1970
CONSERVATION DIVISION
Wichita, Kansas

Name of Plugging Contractor PIPE PULLERS, INC.
Address Box 486, Ellinwood, Kansas

STATE OF Kansas, COUNTY OF Barton, ss.
Evelyn Roth (employee of owner) or (owner or operator) of the above-described

well, being first duly sworn on oath, says: That I have knowledge of the facts, statements, and matters herein contained and the log of the above-described well as filed and that the same are true and correct. So help me God.

(Signature) Evelyn Roth
Ellinwood, Kansas (Address)

SUBSCRIBED AND SWORN TO before me this 3 day of February, 1970

My commission expires July 7, 1972 Notary Public.

15-051-02077-0000
COPY


WELL LOG BUREAU—KANSAS GEOLOGICAL SOCIETY
508 East Murdock, Wichita, Kansas

Company- **TOMLINSON-KATHOL, INC.**
Farm- Nielsen No. 4

SEC. 28 T. 11 R. 16W
SW NW SW

Total Depth. 3410'
Comm. 5-8-59 Comp. 5-17-59
Shot or Treated.
Contractor. Tomlinson-Kathol, Inc.
Issued. 8-22-59

County Ellis
KANSAS

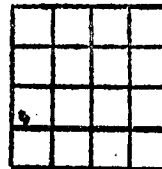

CASING:
8 5/8" 982' cem w/475 sx.

Elevation. 1699' KB

Production. 30 BOPD

Figures indicate Bottom of Formations.

clay & post rocks	35
shale & sand strks	157
shale	400
sand	550
shale	690
red shale	960
Anhydrite	1006
shale & lime	1310
shale	1835
shale & lime	1990
lime & shale	2105
lime	2406
shale & lime	2594
shale	2767
lime & shale	2844
lime	2930
lime & shale	3016
lime	3329
Arbuckle	3410 RTD
Total Depth	

TOPS:

Anhydrite (scout)	960
Heebner	2972
Toronto	2992
Lansing	3020
Base Kansas City	3264
Arbuckle	3323

RECEIVED
STATE CORPORATION COMMISSION
DEC 29 1969
CONSERVATION DIVISION
Wichita, Kansas