

NOTICE OF INTENTION TO DRILL

(see rules on reverse side)

Expected Spud Date. 11 month 10 day 1987 year

API Number 15-091-21,914-0000

OPERATOR: License # 5095
Name GERALD E. WILLIAMS
Address P. O. BOX 25830
City/State/Zip Overland Park, Ks. 66225
Contact Person Susie Glaze
Phone (913) 764-2625

SE NE NW Sec. 28 Twp. 14 S, Rg. 22
4100 Ft. from South Line of Section
2895 Ft. from East Line of Section

(Note: Locate well on Section Plat on reverse side)

CONTRACTOR: License # 5885
Name Alva G. Glaze Drlg. Co.
City/State Olathe, Kansas 66061

Nearest lease or unit boundary line 165 feet
County JOHNSON
Lease Name HICKS Well # 9

Well Drilled For: Well Class: Type Equipment:
[X] Oil Storage Infield Mud Rotary
Gas Inj Pool Ext. [X] Air Rotary
OWWO Expl [X] Wildcat Cable

Ground surface elevation feet MSL
Domestic well within 330 feet: yes [X] no
Municipal well within one mile: yes [X] no
Depth to bottom of fresh water 0
Depth to bottom of usable water 300
Surface pipe by Alternate: 1 2 [X]
Surface pipe planned to be set 20
Conductor pipe required None
Projected Total Depth 900 feet
Formation Bartlesville

If OWWO: old well info as follows:

Operator
Well Name
Comp Date Old Total Depth

I certify that well will comply with K.S.A. 55-101, et seq., plus eventually plugging hole to KCC specifications.

Date 11-5-87 Signature of Operator or Agent [Signature] Title Agent

For KCC Use:

Conductor Pipe Required feet; Minimum Surface Pipe Required 20 feet per Alt. X (2)

This Authorization Expires 5-5-88 Approved By [Signature] 11-5-87


EFFECTIVE DATE: 11-10-87

Must be filed with the K.C.C. five (5) days prior to commencing well  
This card void if drilling not started within six (6) months of date received by K.C.C.

**Important procedures to follow:**

1. Notify District office before setting surface casing.
2. Set surface casing by circulating cement to the top.
3. File completion forms ACO-1 with K.C.C. within 120 days of well spud date, following instructions on ACO-1, side 1, and including copies of wireline logs.
4. Notify District office 48 hours prior to old well workover or re-entry.
5. Prior to filing Intent, prepare a proposed plugging plan in case well is D & A, then obtain approval of plan when calling district office prior to setting surface pipe.
6. Submit plugging report (CP-4) to K.C.C. after plugging is completed.
7. Obtain an approved injection docket number before disposing of salt water.
8. Notify K.C.C. within 10 days when injection commences or terminates.
9. If an alternate 2 completion, cement in the production pipe from below any usable water to surface within 120 days of spud date.

**A Regular Section of Land**  
**1 Mile = 5,280 Ft.**

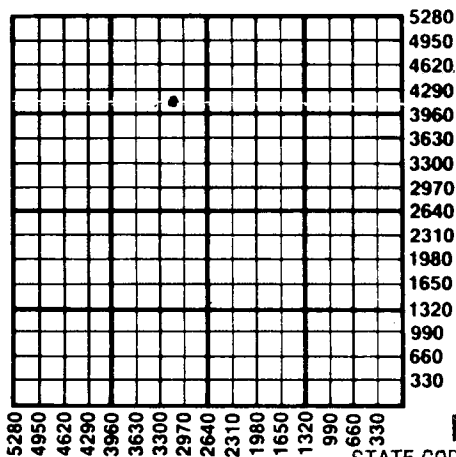

RECEIVED  
STATE CORPORATION COMMISSION

NOV 5 1987

CONSERVATION DIVISION  
Wichita, Kansas

State Corporation Commission of Kansas  
Conservation Division  
200 Colorado Derby Building  
Wichita, Kansas 67202-1212  
(316) 263-3238