

EFFECTIVE DATE: 11-3-90

State of Kansas

NOTICE OF INTENTION TO DRILL

Must be approved by the K.C. five (5) days prior to commencing well

Expected Spud Date 11 1990
month day year

NB NW SE Sec 1 Twp 11 S, Rg 17 East West

OPERATOR: License # 6273
Name: ROBERT R. PRICE OPERATING, INC.
Address: P.O. Box 470442
City/State/Zip: Tulsa, Oklahoma 74147
Contact Person: Robert R. Price
Phone: AC. 918. 492-1694

2310 feet from South line of Section
1650 feet from East line of Section
(Note: Locate well on Section Plat on Reverse Side)

CONTRACTOR: License #: 5302
Name: Red Tiger Drilling Company

County: Ellis
Lease Name: Richmond "A" Well #: 8
Field Name: Lieb NW
Is this a Prorated Field? ... yes no
Target Formation(s): Lansing-KC, Arbuckle
Nearest lease or unit boundary: 330
Ground Surface Elevation: 1883 feet MSE
Domestic well within 330 feet: ... yes no
Municipal well within one mile: ... yes no
Depth to bottom of fresh water: 125' 100'
Depth to bottom of usable water: 125' 125'
Surface Pipe by Alternate: ... 1 2
Length of Surface Pipe Planned to be set: 200'
Length of Conductor pipe required: None
Projected Total Depth: 3475'
Formation at Total Depth: Arbuckle
Water Source for Drilling Operations:
... well farm pond ... other
DWR Permit #: _____
Will Cores Be Taken?: ... yes no
If yes, proposed zone: _____

Well Drilled For: Well Class: Type Equipment:
 Oil ... Inj ... Infield Mud Rotary
... Gas ... Storage Pool Ext. ... Air Rotary
... OWWD ... Disposal ... Wildcat ... Cable
... Seismic; ... # of Holes

If OWWD: old well information as follows:
Operator: _____
Well Name: _____
Comp. Date: _____ Old Total Depth _____

Directional, Deviated or Horizontal wellbore? ... yes no
If yes, total depth location: _____

AFFIDAVIT

The undersigned hereby affirms that the drilling, completion and eventual plugging of this well will comply with K.S.A. 55-101, et. seq.

It is agreed that the following minimum requirements will be met:

1. The appropriate district office shall be notified before setting surface pipe;
2. The minimum amount of surface pipe as specified above shall be set by circulating cement to the top; in all cases surface pipe shall be set through all unconsolidated materials plus a minimum of 20 feet into the underlying formation;
3. If the well is dry, a plugging proposal shall be submitted to the district office. An agreement between the operator and the district office on plug length and placement is necessary prior to plugging;
4. The appropriate district office will be notified before well is either plugged or production casing is cemented in;
5. If an Alternate II completion, production pipe shall be cemented from below any usable water to surface within 120 days of spud date. In all cases, notify district office prior to any cementing.

I hereby certify that the statements made herein are true and to the best of my knowledge and belief.

Date: 10-15-90 Signature of Operator or Agent: _____ Title: President

FOR KCC USE:

API # 15- 051-24,713
 Conductor pipe required None feet
 Minimum surface pipe required 300 feet per Alt. ②
 Approved by: MRW 10-29-90
 EFFECTIVE DATE: 11-3-90
 This authorization expires: 7-29-91
 (This authorization void if drilling not started within 6 months of effective date.)
 Spud date: _____ Agent: _____

RECEIVED
STATE CORPORATION COMMISSION
10-22-1990
OCT 22 1990

CONSERVATION DIVISION
Wichita, Kansas

REMEMBER TO:

- File Drill Pit Application (form CDP-1) with Intent to Drill;
- File Completion Form ACO-1 within 120 days of spud date;
- File acreage attribution plat according to field proration orders;
- Notify appropriate district office 48 hours prior to workover or re-entry;
- Submit plugging report (CP-4) after plugging is completed;
- Obtain written approval before disposing or injecting salt water.

STAMP

10-29-1990
OCT 29 1990


T
11
120

PLAT OF ACREAGE ATTRIBUTABLE TO A WELL

State Corporation Commission, Conservation Division
200 Colorado Derby Bldg. Wichita, Kansas 67202

OPERATOR ROBERT R. PRICE OPERATING, INC. LOCATION OF WELL: NB NW SE
 LEASE Richmond "A" 2310 feet north of SE corner
 WELL NUMBER 8 1650 feet west of SE corner
 FIELD Lieb NW Sec. 1 T 11S R 17 E/W
 COUNTY Ellis
 NO. OF ACRES ATTRIBUTABLE TO WELL 20 IS SECTION REGULAR IRREGULAR?
 DESCRIPTION OF ACREAGE On plat below IF IRREGULAR, LOCATE WELL FROM NEAREST CORNER BOUNDARY.

NOTE: If plat depicted is insufficient for your circumstances, you may attach your own scaled or surveyed plat.

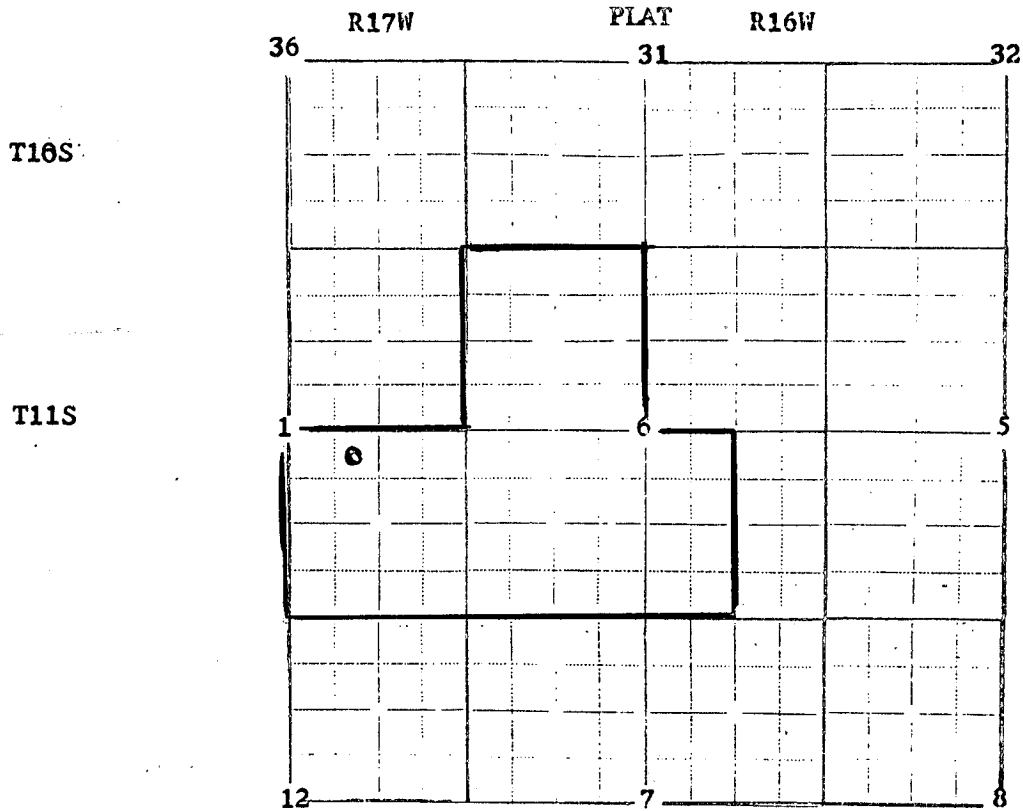

In plotting the proposed location of the well, you must show:

- 1) The manner in which you are using the depicted plat by identifying section lines, i.e. 1 section, 1 section with 8 surrounding partial sections, 4 sections, 16 sections, etc.;
- 2) the well's location relative to the location of other wells producing from the same common source of supply in adjoining drilling units, pursuant to K.A.R. 82-3-108, 82-3-207, 82-3-312, or special orders of the Commission;
- 3) the distance of the proposed drilling location from the section's east and south lines; and
- 4) the distance to the nearest lease or unit boundary line.

I hereby certify that the statements made herein are true and to the best of my knowledge and belief.

Signature of Operator or Agent *Robert R. Price*

Date 10-15-90 Title President