

15-075-10047-00-00

STATE OF KANSAS
STATE CORPORATION COMMISSION


Give All Information Completely
Make Required Affidavit
Mail or Deliver Report to:
Conservation Division
State Corporation Commission
211 No. Broadway
Wichita, Kansas

WELL PLUGGING RECORD

Hamilton County. Sec. 26 Twp. 25 Rge. (E) 39 (W)

Location as "NE/CNW%SW%" or footage from lines C SE/4
Lease Owner Kansas-Nebraska Natural Gas Company, Inc.
Lease Name Englert Well No# 1
Office Address 300 North St. Joseph, Hastings, Nebraska 68901
Character of Well (completed as Oil, Gas or Dry Hole) Gas
Date well completed 11-20 1960
Application for plugging filed 3-13 1967
Application for plugging approved 3-14 1967
Plugging commenced 5-1 1967
Plugging completed 5-1 1967
Reason for abandonment of well or producing formation No longer capable of commercial production
If a producing well is abandoned, date of last production 3-15 1967
Was permission obtained from the Conservation Division or its agents before plugging was commenced? Yes

NORTH

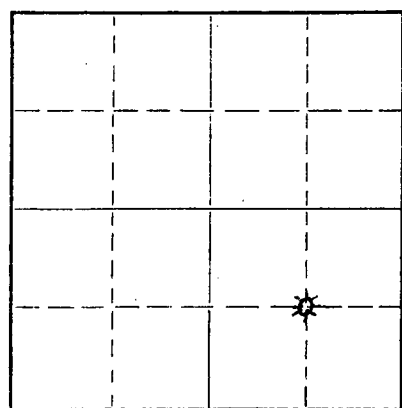

Locate well correctly on above Section Plat

Name of Conservation Agent who supervised plugging of this well Edgar Eves
Producing formation Krider & Winfield Depth to top 2460 Bottom 2540 Total Depth of Well 3060 Feet
Show depth and thickness of all water, oil and gas formations.

OIL, GAS OR WATER RECORDS

CASING RECORD

FORMATION	CONTENT	FROM	TO	SIZE	PUT IN	PULLED OUT
Krider	Gas	2460	2475	8 5/8	302	None
Winfield	Gas	2511	2530	5 1/2	3058	1482
Council Grove	Water	2801	2908			
Admire	Water	3005	3036			

Describe in detail the manner in which the well was plugged, indicating where the mud fluid was placed and the method or methods used in introducing it into the hole. If cement or other plugs were used, state the character of same and depth placed, from _____ feet to _____ feet for each plug set.

Mixed one sack cotton seed hulls and 20 sacks cement with pump truck. Pumped plug to 2211.

Shot pipe free at 1882'. Pulled 1482'. Circulated mud at 400'. Pulled two joints.

Mixed 35 sacks cement with pump truck and spotted cement plug 35-' to 250'. Pulled remaining 350' of pipe.

Mixed and placed 15 sacks cement, 45' to 0' for top plug.

RECEIVED
STATE CORPORATION COMMISSION

MAY 31 1967

CONSERVATION DIVISION
Wichita, Kansas


(If additional description is necessary, use BACK of this sheet)

Name of Plugging Contractor Sargent Casing Pulling Service
Address Liberal, Kansas

STATE OF NEBRASKA, COUNTY OF ADAMS, ss.
Thomas C. Swanson (employee of owner) or (~~owner or operator~~) of the above-described well, being first duly sworn on oath, says: That I have knowledge of the facts, statements, and matters herein contained and the log of the above-described well as filed and that the same are true and correct. So help me God.

(Signature) Thomas C. Swanson
Thomas C. Swanson, General Supt. of Production
300 N. St. Joseph Ave., Hastings, Nebr. 68901
(Address)

SUBSCRIBED AND SWORN TO before me this May 29 day of May, 19 67

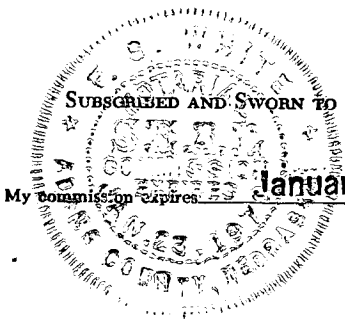

F. S. White
Notary Public.

15-075-10047-00-00

DRILLERS LOG

Englert - 1
Loc: Center SE/4
Sec: 26-25S-39W
Hamilton County, Kansas
Company: Kansas-Nebraska Natural Gas Co., Inc.
Contractor: Davis Drilg., Inc.

Comm: 10-27-60
Comp: 11-5-60
Rotary Total Depth: 3060'
Casing: 8-5/8" at 305'
5-1/2" at 3058'


0	40	Top Soil & Clay	
40	140	Clay & Gravel	
140	305	Blue Shale	8-5/8" casing cemented at 305' w/ 225 sacks cement & 2% Calcium Chloride.
305	647	Shale	
647	815	Red Bed	
815	838	Anhydrite	
838	1185	Red Bed & Sand	
1185	1620	Red Bed & Shale	
1620	2295	Shale & Red Bed	
2295	2350	Gyp & Shale	
2350	2465	Shale & Lime	
2465	2660	Lime & Shale	
2660	2865	Shale & Lime	
2865	2960	Lime & Shale	
2960	3060	Lime	5-1/2" casing cemented at 3058' w/ 225 sacks Portland Cement.
3060		Total Rotary Depth	

RECEIVED
STATE CORPORATION COMMISSION


MAY 31 1967

CONSERVATION DIVISION
Wichita, Kansas

I certify that this is the true and correct copy of the above log, to the best of my knowledge.

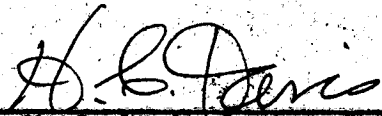
H. C. Davis

Subscribed and sworn to before me this 8th day of November, 1960.


Kenneth G. Fischer
Notary Public

My Commission Expires: 6-25-65