

WELL PLUGGING RECORD

STATE OF KANSAS STATE CORPORATION COMMISSION


OR

FORMATION PLUGGING RECORD

Strike out upper line when reporting plugging of formations.

Give All Information Completely Make Required Affidavit Mail or Deliver Report to: Conservation Division State Corporation Commission 800 Bittling Building Wichita, Kansas

RUSSELL County. Sec. 12 Twp. 13 Rge. 13 (E) W (W) Location as "NE 1/4 NW 1/4 SW 1/4" or footage from lines. SE SE NW Lease Owner: B & R DRILLING, INC. Lease Name: DAUBER Well No. #1 Office Address: RUSSELL, KANSAS Character of Well (completed as Oil, Gas or Dry Hole) DRY HOLE Date well completed: 8/12/49 Application for plugging filed: 8/26/49 Verbally Application for plugging approved: 8/26/49 Verbally Plugging commenced: 8/26/49 Plugging completed: 9/3/49 Reason for abandonment of well or producing formation: DRY HOLE

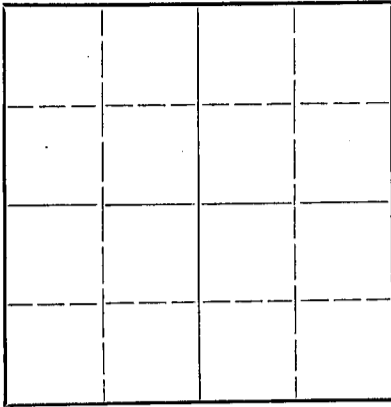

Locate well correctly on above Section Plat

Name of Conservation Agent who supervised plugging of this well: MR. ELDON PETTY Producing formation: Depth to top: Bottom: Total Depth of Well: 3275 Feet Show depth and thickness of all water, oil and gas formations.

OIL, GAS OR WATER RECORDS

CASING RECORD

Table with 7 columns: Formation, Content, From, To, Size, Put In, Pulled Out. Row 1: 8 5/8", 293', none. Row 2: 5 1/2", 2997', 2657'.

Describe in detail the manner in which the well was plugged, indicating where the mud fluid was placed and the method or methods used in introducing it into the hold. If cement or other plugs were used, state the character of same and depth placed, from... feet to ... feet for each plug set.

Filled hole with crushed rock from 2820' to 2795'. Dumped 5 sacks cement at 2795' with dump bailer; top of cement 2760'. Filled with mud to 290', set rock bridge, dumped 15 sacks cement. Top of cement at 250'. Filled with mud to 35', dumped 10 sacks cement for cap.

09-10-1949

(If additional description is necessary, use BACK of this sheet)

Correspondence regarding this well should be addressed to: B & R DRILLING, INC. Address: RUSSELL, KANSAS

STATE OF KANSAS, COUNTY OF RUSSELL, ss. DON ROBERTS (employee of owner) or (owner or operator) of the above-described well, being first duly sworn on oath, says: That I have knowledge of the facts, statements, and matters herein contained and the log of the above-described well as filed and that the same are true and correct. So help me God.

(Signature) [Signature]

RUSSELL, KANSAS (Address)

SUBSCRIBED AND SWORN to before me this 8th day of SEPTEMBER, 1949

My commission expires 6/17/50

PLUGGING FILE EC-18713 R130 118 48

Notary Public. [Signature]

B & R DRILLING, INC.
DAUBER # 1

SEC. 12 TWP. 13 RGE. 13
RUSSELL COUNTY, KANSAS

Total Depth: 3275'
Comm: 7/27/49 Comp: 8/12/49

Casing	Cement
8 5/8" Set @ 292'	225 Sacks
5 1/2" Set @ 2997'	75 Sacks

Formation:	Depth:
Surface soil	35
Sand	45
Sand & Shale	95
Shale & Shells	225
Shale & Sand	275
Shale & Red Bed	292
Shale & Shell	385
Red Bed	568
Anhydrite	610
Shale & Red Bed	730
Shale & Shells	960
Shale & Salt	1200
Shale & Shell	1320
Shale & Lime	2659
Lime	2723
Lime & Shale	2805
Lime	3117
Shale	3128
Cherty Congl	3190
Lime	3218
Lime & Shale	3243
Arbuckle	3275

STATE OF KANSAS)
) SS
RUSSELL COUNTY)

I hereby certify that the above information is true and correct to the best of my knowledge.

Violet P. Keller

Notary Public

Subscribed and sworn to before me this 15th day of August, 1949

Clara Sumner

Notary Public

09-10-1949

My commission expires: 6/17/50

PLUGGING
FILE SEC 12 T 13 R 13C
BOOK PAGE 118 LINE 48