


OR
FORMATION PLUGGING RECORD

Strike out upper line
when reporting plug-
ging off formations.

Give All Information Completely
Make Required Affidavit
Mail or Deliver Report to:
Conservation Division
State Corporation Commission
800 Biting Building
Wichita, Kansas

NORTH

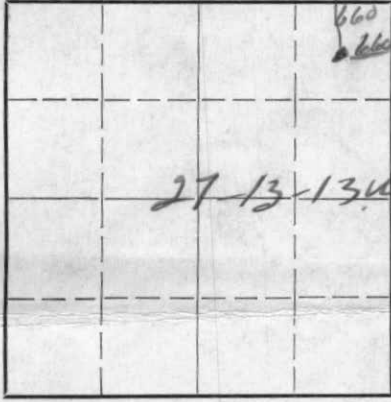

Locate well correctly on above
Section Plat

Russell County, Sec 27 Twp 13 Rge (E) 13 (W)
Location as "NE 1/4 NW 1/4 SW 1/4" or footage from lines. Line NE-NE
Lease Owner M. B. Olson
Lease Name Olson Well No. 1
Office Address South National Bank Wichita Kan.
Character of Well (completed as Oil, Gas or Dry Hole) Dry Hole
Date well completed 2-21-1944 1944
Application for plugging filed Same day. 1944
Application for plugging approved ✓✓ ✓✓ 1944
Plugging commenced ✓✓ ✓✓ 1944
Plugging completed 2-23-1944 1944
Reason for abandonment of well or producing formation. No oil water

If a producing well is abandoned, date of last production..... 19.....
Was permission obtained from the Conservation Division or its agents before plugging was com-
menced? Yes

Name of Conservation Agent who supervised plugging of this well E. T. Alexander
Producing formation None Depth to top..... Bottom..... Total Depth of Well 3422 Feet
Show depth and thickness of all water, oil and gas formations.

OIL, GAS OR WATER RECORDS


CASING RECORD

Formation	Content	From	To	Size	Put In	Pulled Out
<u>Sandy Lime</u>	<u>Water</u>	<u>220</u>	<u>235'</u>	<u>1 1/2"</u>	<u>485</u>	<u>485</u>
<u>Sand</u>	<u>Water</u>	<u>470</u>	<u>475</u>	<u>10"</u>	<u>798</u>	<u>798</u>
<u>Shale & Shells</u>	<u>Water 2 Bails</u>	<u>2430</u>	<u>2485</u>	<u>8"</u>	<u>2504</u>	<u>2504</u>
<u>Broken Lime</u>	<u>Water 1 Bail</u>	<u>2475</u>	<u>2480</u>	<u>7"</u>	<u>3090</u>	<u>3090</u>
<u>Lime</u>	<u>Water 2 Bails</u>	<u>3080</u>	<u>3085</u>	<u>5 1/2"</u>	<u>3385</u>	<u>3385</u>
<u>Lime</u>	<u>Water</u>	<u>3420</u>	<u>3422</u>			

Describe in detail the manner in which the well was plugged, indicating where the mud fluid was placed and the method or methods used in introducing it into the hold. If cement or other plugs were used, state the character of same and depth placed, from.....feet to.....feet for each plug set.

filled hole with water then cemented with dump 13 pipes from 3422 to 3398 pulled 5 1/2' mud 3000 pulled 7" up to 2504 and filled with mud pulled 7" started 8" filled with mud pulled 8" started 10" filled with mud pulled 10" started 12 1/2' put in some mud pulled up to 250 set wood plug at 285 put in some pop dumped cement to 240 filled with mud pulled 12 1/2' filled hole with mud to 20 ft of top cement to Bottom of collar.

PLUGGING
FILE SEC 27 13 R13W
BOOK PAGE 109 LINE 1

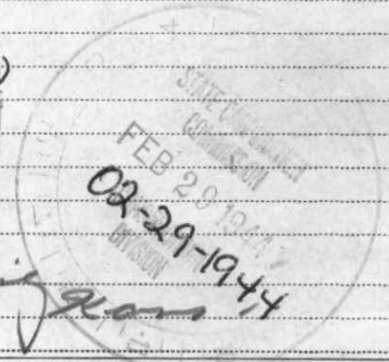

(If additional description is necessary, use BACK of this sheet)

Correspondence regarding this well should be addressed to B. A. Duffing
Address South National Bank Wichita Kansas

STATE OF Kansas, COUNTY OF Barston, ss.
Frank Wood (employee of owner) or (owner or operator) of the above-described well,
being first duly sworn on oath, says: That I have knowledge of the facts, statements, and matters herein contained and the log of the above-described well as filed and that the same are true and correct. So help me God:

(Signature) Frank Wood
(Address) Horsington Kansas

SUBSCRIBED AND SWORN to before me this 25 day of February, 1944
Ray Smith Notary Public.

My commission expires Nov 18, 1947

B-167-00493-00-00

M. B. ARMER

Description: Center NE NE 27-13S-13W
Russell County, Kansas

Commenced: 1-11-44
Completed: 2-21-44

Elevation: 1819'

Farm Name : Olson #1

Total Depth: 3422'

Cellar	8	Blue Shale	3005
Rock	12	Sandy Shale	3010
Yellow Clay	15	Lime	3030
Blue Shale	40	Red & Blue Shale	3035
Shale	200	Shale	3060
Sandy Lime	235	Lime, K. C.	3072
Shale	250	Shale	3080
Red Shale	275	Lime	3135
Shale	385	Shale	3140
Blue Shale	425	Lime	3210
Shale	470	Sandy Lime	3230
Sand	475	Lime	3240
Red Shale	787	Shale	3245
Lime	830	Lime	3285
Red Shale	980	Shale	3290
Blue Shale	1030	Lime	3317
Red Shale	1075	Shale	3325
Blue Shale	1105	Lime	3345
Shale	1200	Shale	3350
Salt	1445	Lime	3360
Shale	1475	Conglomerate	3385
Lime	1485	Lime	3389
Shale	1500	Conglomerate	3397
Broken Lime	1580	Broken Sand	3405
Red Rock	1585	Lime	3422
Lime	1590	Total Depth	3422
Shale & Shells	1650		
Red Rock	1655	Water Record:	
Shale & Shells	1705	Water H. F.	220
Red Rock	1720	"	2430-2440
Lime	1875	"	2475-2480
Shale	1900	"	3080-3085
Lime	1925	"	3420-3422
Shale	1930		
Sandy Lime	1970	Seamed 7" -	2938-3093
Lime	2000		
Red Rock	2005	Casing Record:	
Lime	2075	12 1/2" -	485
Red Rock	2085	10" -	795
Lime	2115	8" -	2435
Shale	2125	7" -	2938
Lime	2130	5" -	3385
Shale	2140(Cave)		
Lime	2150	Show of gas	2425 - 2430
Red Rock	2160		
Shale	2200		
Lime	2225		
Shale	2240		
Shale & Shells	2305(Caving 2305 to		
Shale	2470 2470)	Dry Hole - Plugged	2/21/44
Broken Lime	2480		
Lime	2490		
Shale	2500		
Lime	2505		
Sandy Shale	2530		
Shale	2570(Cave)		
Shale	2585		
Lime	2595		
Shale	2615		
Lime	2630		
Shale	2750		
Lime	2845		
Shale	2850		
Lime	2995		

Certified Correct:

M. B. Armer

PLUGGING
FILE SEC 27 13 13W
BOOK PAGE 109 HNE 1

02-29-1944