


STATE OF KANSAS  
STATE CORPORATION COMMISSION

Give All Information Completely  
Make Required Affidavit  
Mail or Deliver Report to:  
Conservation Division  
State Corporation Commission  
211 No. Broadway  
Wichita, Kansas

15-007-01712-00-00  
WELL PLUGGING RECORD

NORTH

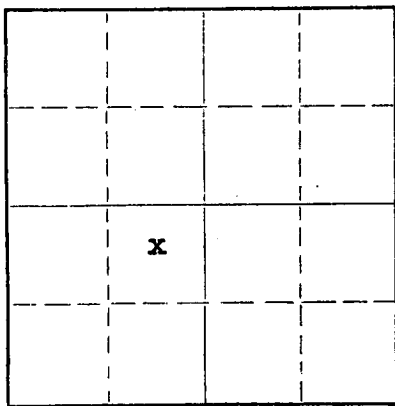

Locate well correctly on above Section Plat

Barber County, Sec. 20 Twp. 32S Rge. 13W (E) (W)  
Location as "NE/CNW/SW" or footage from lines C NE SW  
Lease Owner Sunray Mid-Continent Oil Company  
Lease Name Mae Tedrow Well No. 2  
Office Address 321 West Douglas - Wichita, Kansas  
Character of Well (completed as Oil, Gas or Dry Hole) Dry Hole  
Date well completed Nov. 19 19 61  
Application for plugging filed Nov. 20 19 61  
Application for plugging approved Nov. 20 19 61  
Plugging commenced Nov 20 19 61  
Plugging completed Nov 20 11:A.M. 19 61  
Reason for abandonment of well or producing formation Dry Hole

If a producing well is abandoned, date of last production ----- 19  
Was permission obtained from the Conservation Division or its agents before plugging was commenced? Yes

Name of Conservation Agent who supervised plugging of this well Fred W. Hampel  
Producing formation None Depth to top ----- Bottom ----- Total Depth of Well 4610' Feet  
Show depth and thickness of all water, oil and gas formations.

OIL, GAS OR WATER RECORDS

CASING RECORD

FORMATION	CONTENT	FROM	TO	SIZE	PUT IN	PULLED OUT
Marmaton	Dry	4482	4513	13-3/8"	206'	-0-
Massey	Mud-Wtr.	4523	4532	8-5/8"	1017'	-0-
Mississippi Ln.	Dry	4544	TD			

Describe in detail the manner in which the well was plugged, indicating where the mud fluid was placed and the method or methods used in introducing it into the hole. If cement or other plugs were used, state the character of same and depth placed, from ----- feet to ----- feet for each plug set.  
Filled hole with mud from 4610' to 300'. Set Halliburton Plug @ 300' and 1/4 sack hulls. Twenty sacks cement placed on top of plug. Filled hole with mud to 40' and set Halliburton Plug and 1/4 sack hulls. Plugged hole to surface with 10 sacks cement. Plugged rat hole.

*Rec'd 12-24-61*

(If additional description is necessary, use BACK of this sheet)  
Name of Plugging Contractor Mora Drilling Co.  
Address 800 Midstates Building -- Tulsa, Oklahoma

STATE OF Kansas, COUNTY OF Sedgwick, ss.  
Nash A. Cough (employee of owner) of the above-described well, being first duly sworn on oath, says: That I have knowledge of the facts, statements, and matters herein contained and the log of the above-described well as filed and that the same are true and correct. So help me God.  
(Signature) *Nash A. Cough*  
321 West Douglas - Wichita, Kansas (Address)

SUBSCRIBED AND SWORN to before me this 23 day of November, 1961

My commission expires July 13, 1963 Notary Public.



# MORA DRILLING COMPANY *PR-4*

1988-FIRST NATIONAL BUILDING  
Midstates  
TULSA 3, OKLAHOMA

November 21, 1961

Sunray Mid-Continent Oil Co.  
Tulsa, Okla.

Gentlemen:

The following is drillers log of your #2 Tedrow drilled in the C NE SW of Sec. 20-32S-15W Barber County, Kans.

Drilling Started Nov. 4, 1961  
Completed Nov. 19, 1961

Formation	From	To
Gyp and Red Bed	0	250
Shale and shells	250	1027
Shale	1027	1920
Shale and lime	1920	2165
Lime	2165	2720
Shale and lime	2720	3703
Lime	3703	3757
Shale and lime	3757	4034
Shale and sand	4034	4070
Lime	4070	4611 TD

Yours truly,

*H.P. Burris*

**RECEIVED**  
STATE CORPORATION COMMISSION  
NOV 23 1961  
CONSERVATION DIVISION  
Wichita, Kansas