


STATE OF KANSAS  
STATE CORPORATION COMMISSION

Give All Information Completely  
Make Required Affidavit  
Mail or Deliver Report to:  
Conservation Division  
State Corporation Commission  
211 No. Broadway  
Wichita, Kansas

WELL PLUGGING RECORD

Ellis County. Sec. 34 Twp. 11 Rge. (E) 16 (W)  
Location as "NE/CNW/SW" or footage from lines SE NW SE  
Lease Owner Louis M. Mai Operations  
Lease Name Chrisler Well No. 1  
Office Address Box 33 Russell, Kansas  
Character of Well (completed as Oil, Gas or Dry Hole) Dry Hole  
Date well completed 2-16 19 63  
Application for plugging filed 2-16 19 63  
Application for plugging approved 2-16 19 63  
Plugging commenced 2-16 19 63  
Plugging completed 2-16 19 63  
Reason for abandonment of well or producing formation Dry Hole

NORTH

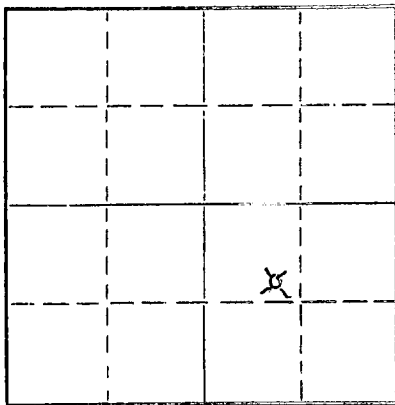

Locate well correctly on above  
Section Plat

If a producing well is abandoned, date of last production 19  
Was permission obtained from the Conservation Division or its agents before plugging was com-  
menced? yes

Name of Conservation Agent who supervised plugging of this well Eldon Petty  
Producing formation Depth to top Bottom Total Depth of Well 3410 Feet  
Show depth and thickness of all water, oil and gas formations.

OIL, GAS OR WATER RECORDS

CASING RECORD

FORMATION	CONTENT	FROM	TO	SIZE	PUT IN	PULLED OUT
				8 5/8"	248'	none

Describe in detail the manner in which the well was plugged, indicating where the mud fluid was placed and the method or methods used in introducing it into the hole. If cement or other plugs were used, state the character of same and depth placed, from feet to feet for each plug set.  
Bottom plug at 480' with 20 sacks of cement through drill pipe, mud to 240',  
plug, 1/2 sacks of hull, 20 sacks of cement, mud to 40', plug, 1/2 sacks of  
hull, 10 sacks of cement.

RECEIVED  
STATE CORPORATION COMMISSION  
2-27-1963  
FEB 27 1963  
CONSERVATION DIVISION  
Wichita, Kansas


(If additional description is necessary, use BACK of this sheet)  
Name of Plugging Contractor Mast Drilling, Inc.  
Address Box 33 Russell, Kansas

STATE OF KANSAS, COUNTY OF RUSSELL, ss.  
Louis M. Mai (employee of owner) or (owner or operator) of the above-described well, being first duly sworn on oath, says: That I have knowledge of the facts, statements, and matters herein contained and the log of the above-described well as filed and that the same are true and correct. So help me God.

(Signature) Louis M. Mai  
Box 33 Russell, Kansas  
(Address)

SUBSCRIBED AND SWORN TO before me this 22 day of February, 19 63

Beverly Haynes  
Beverly Haynes Notary Public.

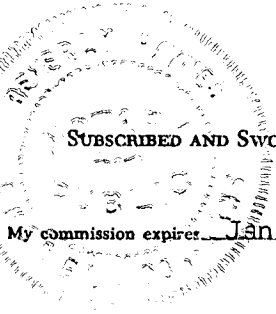

WELL LOG

OPERATOR: Louis M. Mai Operations  
 Box 33  
 Russell, Kansas

CONTRACTOR: Mast Drilling, Inc.  
 Box 33  
 Russell, Kansas

LEASE: Chrisler No. 1  
 SE NW SE  
 Sec. 34, T11, R16W  
 Ellis County, Kansas

CASING: 8 5/8" Set @ 248

CEMENT: 175 sacks HA.5

COMMENCED: 2-7-63

COMPLETED: 2-15-63

FORMATION	DEPTH
Clay & Sand	215
Blue Shale	248
Shale & Sand	540
Sand	640
Red Bed	1001
Anhydrite	1041
Red Bed & Shale	1325
Shale	1695
Lime & Shale	2035
Lime	2165
Lime & Shale	2457
Shale	2655
Shale & Lime	2857
Lime	2992
Lime & Shale	3069
Lime	3194
Lime & Shale	3266
Lime	3373
Lime & Shale	3391
Simpson	3394
Arbuckle	3410
TOTAL DEPTH	3410

**RECEIVED**  
 STATE CORPORATION COMMISSION  
 2-27-1963  
 FEB 27 1963

CONSERVATION DIVISION  
 Wichita, Kansas

STATE OF KANSAS)  
 )SS  
 RUSSELL COUNTY))

I hereby certify that the above information is true  
 and correct to the best of my knowledge.

Louis M. Mai

Subscribed and sworn to before me this 21st day of February, 1963

Beverly Hayes  
 Notary Public

My commission expires: 1-8-66

