


STATE OF KANSAS
STATE CORPORATION COMMISSION

Give All Information Completely
Make Required Affidavit
Mail or Deliver Report to:
Conservation Division
State Corporation Commission
212 North Market, Insurance Bldg.
Wichita, Kansas

WELL PLUGGING RECORD

NORTH

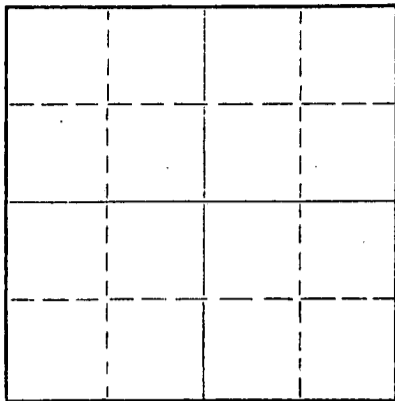

Locate well correctly on above
Section Plat

Ellis County. Sec. 34 Twp. 11S Rge. 16W (X) (W)
Location as "NE/CNW/SW" or footage from lines NE/C NW/4
Lease Owner Franco Central Oil Company
Lease Name Chrisler Well No. 1
Office Address 750 Fourth National Bank Building, Wichita, Ks
Character of Well (completed as Oil, Gas or Dry Hole) D & A
Date well completed October 29, 1960 19
Application for plugging filed October 29, 1960 19
Application for plugging approved October 29, 1960
Plugging commenced October 29, 1960
Plugging completed October 29, 1960
Reason for abandonment of well or producing formation D & A

If a producing well is abandoned, date of last production _____ 19____
Was permission obtained from the Conservation Division or its agents before plugging was commenced? Yes

Name of Conservation Agent who supervised plugging of this well Eldon Petty
Producing formation _____ Depth to top _____ Bottom _____ Total Depth of Well _____ Feet
Show depth and thickness of all water, oil and gas formations.

OIL, GAS OR WATER RECORDS

CASING RECORD

FORMATION	CONTENT	FROM	TO	SIZE	PUT IN	PULLED OUT
				8 5/8"	252'	-0-

Describe in detail the manner in which the well was plugged, indicating where the mud fluid was placed and the method or methods used in introducing it into the hole. If cement or other plugs were used, state the character of same and depth placed, from _____ feet to _____ feet for each plug set.

Set bottom plug at 350' with 20 sx cement. Set middle plug at 240' with 20 sx. Set top plug @ 40' with 1/2 sx hulls and 10 sx cement.

RECEIVED
STATE CORPORATION COMMISSION
NOV 1 1960
CONSERVATION DIVISION
Wichita, Kansas

(If additional description is necessary, use BACK of this sheet)

Name of Plugging Contractor Red Tiger Drilling
Address Box 173, Russell, Kansas

STATE OF KANSAS, COUNTY OF SEDGWICK, ss.
George A. Angle

(owner or operator) of the above-described well, being first duly sworn on oath, says: That I have knowledge of the facts, statements, and matters herein contained and the log of the above-described well as filed and that the same are true and correct. So help me God.

(Signature) George A. Angle
580 Fourth National Bank Bldg. Wichita
(Address)

SUBSCRIBED AND SWORN TO before me this 31st day of October, 1960

My commission expires 11-17-62

Wesley Head
Notary Public.



DRILLERS LOG

No. 1 Chrisler

CASING RECORD: 8 5/8" @ 252' w/160 sx cement
 COMPANY: Franco Central Oil Co.
 CONTRACTOR: Red Tiger Drilling Co.
 COMMENCED: October 20, 1960
 COMPLETED: October 29, 1960

DESCRIPTION: NE/C NW/4
 34-11S-16W
 Ellis County,
 Kansas
 ELEVATION:
 1808 DF
 1811 RB

TOTAL DEPTH: 3420'

<u>FORMATION</u>	<u>FROM</u>	<u>TO</u>	<u>REMARKS</u>
Clay and Shale	0	252	
Sand Shale	252	585	
Shale & Shells	585	982	
Anhydrite	982	1024	
Shale	1024	1035	
Shale & Shells	1035	1680	
Shale & Lime	1680	1815	
Lime & Shale	1815	2455	
Shale & Lime	2455	2885	
Lime & Shale	2885	3033	
Lime	3033	3420	

I certify that this is a true and correct copy of the above log to the best of my knowledge.

RED TIGER DRILLING COMPANY

RECEIVED
 STATE CORPORATION COMMISSION
 11-1-1960
 NOV 1 1960

CONSERVATION DIVISION
 Wichita, Kansas

George A. Angle
 George A. Angle

Subscribed and sworn to before me this 31st day of October, 1960.

Maryne Head
 Notary Public

My Commission Expires:

11-17-62