


STATE OF KANSAS
STATE CORPORATION COMMISSION

Form CP-4

Give All Information Completely
Make Required Affidavit
Mail or Deliver Report to:
Conservation Division
State Corporation Commission
212 No. Market
Wichita, Kansas 67202

WELL PLUGGING RECORD

Woodson County. Sec. 18 Twp. 25 Rge. 17 (E) (W)
Location as "NE/CNW/SW" or footage from lines From W. line 250 N. line 400
Lease Owner Walden Bldg.
Lease Name James Bruggeman Well No. _____
Office Address Toronto Kansas
Character of Well (completed as Oil, Gas or Dry Hole) Dry Hole
Date well completed _____ 19____
Application for plugging filed 6-16-70 19____
Application for plugging approved 6-16-70 19____
Plugging commenced 6-16-70 19____
Plugging completed 6-16-70 19____
Reason for abandonment of well or producing formation _____

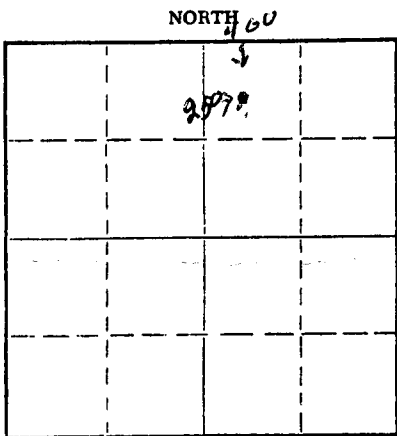

Locate well correctly on above
Section Plat

If a producing well is abandoned, date of last production _____ 19____
Was permission obtained from the Conservation Division or its agents before plugging was com-
menced? _____

Name of Conservation Agent who supervised plugging of this well Marvin W Carbery
Producing formation _____ Depth to top _____ Bottom _____ Total Depth of Well 935 Feet
Show depth and thickness of all water, oil and gas formations.

OIL, GAS OR WATER RECORDS

CASING RECORD

FORMATION	CONTENT	FROM	TO	SIZE	PUT IN	PULLED OUT
<u>clay</u>	<u>water</u>	<u>5</u>	<u>20</u>	<u>10</u>	<u>30 ft</u>	<u>30</u>
<u>fine</u>	<u>water</u>	<u>20</u>	<u>110</u>	<u>8 1/2</u>	<u>435</u>	<u>430</u>
<u>Shale fine</u>	<u>water</u>	<u>170</u>	<u>190</u>			
<u>shale sandy</u>	<u>water</u>	<u>215</u>	<u>250</u>			
<u>fine</u>	<u>water</u>	<u>280</u>	<u>360</u>			
<u>shale</u>	<u>water</u>	<u>635</u>	<u>673</u>			
<u>sand</u>	<u>water</u>	<u>935</u>	<u>935</u>			

Describe in detail the manner in which the well was plugged, indicating where the mud fluid was placed and the method or methods used
in introducing it into the hole. If cement or other plugs were used, state the character of same and depth placed, from _____ feet to
_____ feet for each plug set.

Hole filled with mud from 935 to 200 set a Rock Bridge
at 200 ft cemented on plug or bridge with 10 sacks of cement
set a rock Bridge at 35 ft cement on bridge with
10 sacks cement filled with seal to surface

RECEIVED
STATE CORPORATION COMMISSION
JUL 10 1970
CONSERVATION DIVISION
Wichita, Kansas

(If additional description is necessary, use BACK of this sheet)

Name of Plugging Contractor _____
Address _____

STATE OF Kansas, COUNTY OF Woodson, ss.
Thomas F Walden (employee of owner) or (owner or operator) of the above-described
well, being first duly sworn on oath, says: That I have knowledge of the facts, statements, and matters herein contained and the log of the
above-described well as filed and that the same are true and correct. So help me God.

(Signature) Thomas F Walden

(Address)

SUBSCRIBED AND SWORN to before me this 9 day of July, 1970

My commission expires

Jan 28-1973

Notary Public.

18-25-7E
Bruggeman

started to Drill Sept 1-1969

Well was a Dry Hole T.D. 935-

Soil 0 to 5'
Clay 5 to 20 Water $\frac{1}{2}$ Bailer at 20 ft
Blue shale 20 to 60
~~Blue shale~~ 60 to 70 Hole filled up with water overnight
~~fine~~ Hole casing at 20 ft Run 30 ft of 10# casing
Gray shale 70 to 90
fine 90 to 110 \rightarrow $\frac{3}{4}$ Bailer water at 95 ft
shale & shells 110 to 125
fine 125 to 150
shale 150 to 160
fine 160 to 170
Broken fine 170 to 195 $\frac{3}{4}$ Bailer^w at 195
fine 195 to 215
shale sandy 215 to 250 4 Bailer water at 245 salt water
fine 250 to 255
shale 255 to 290
fine 290 to 360 6 Bailer water at 295
Black shale 360 to 365
fine 365 to 367
shale 367 to 371
fine 371 to 390
Black shale 390 to 392
fine 392 to 400
shale gray 392 to 411
fine 400 to 412
Black shale 411 to 427
fine 412 to 572
shale 427

Run 8 $\frac{1}{4}$ casing at 435-

RECEIVED
STATE CORPORATION COMMISSION
JUL 10 1970
CONSERVATION DIVISION
Wichita, Kansas

fine shells	578 to 600	
fine Hard	600 to 620	
shale	620 to 632	
fine Hard	632 to 635	2 Bails water at 673
shale	635 to 673	
fine Hard	673 to 683	
shale	683 to 685	
fine	685 to 718	
shale Deep	718 to 733	
shale shells	733 to 749	
fine	749 to 755	
shale	755 to 930	Reduced Hole to 6 1/8 at 775
sand	930 to 935	Water Hol casing T.D.

all casing pulled