


WELL PLUGGING RECORD

Give All Information Completely
Make Required Affidavit
Mail or Deliver Report to:
Conservation Division
State Corporation Commission
211 No. Broadway
Wichita, Kansas

NORTH

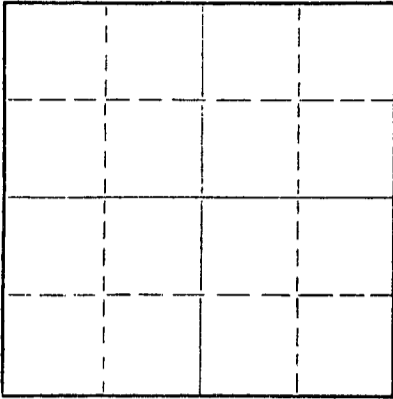

Locate well correctly on above
Section Plat

Russell County. Sec. 23 Twp. 13S Rge. (E) 14 (W)

Location as "NE/CNW/SW" or footage from lines. SW NE NE
Lease Owner Chief Drilling Co., Inc.
Lease Name SPEERE Well No. 1
Office Address Box 797 - Gt. Bend, Kansas 67530
Character of Well (completed as Oil, Gas or Dry Hole) Dry Hole
Date well completed 12/21 19 66
Application for plugging filed 12/21 19 66
Application for plugging approved 12/21 19 66
Plugging commenced 12/21 19 66
Plugging completed 12/21 19 66
Reason for abandonment of well or producing formation Dry Hole

If a producing well is abandoned, date of last production 19
Was permission obtained from the Conservation Division or its agents before plugging was commenced? Yes

Name of Conservation Agent who supervised plugging of this well Don Turan - Russell, Kansas
Producing formation _____ Depth to top _____ Bottom _____ Total Depth of Well 3280 Feet
Show depth and thickness of all water, oil and gas formations.

OIL, GAS OR WATER RECORDS

CASING RECORD

FORMATION	CONTENT	FROM	TO	SIZE	PUT IN	PULLED OUT
		0	205	8-5/8"	205	None

Describe in detail the manner in which the well was plugged, indicating where the mud fluid was placed and the method or methods used in introducing it into the hole. If cement or other plugs were used, state the character of same and depth placed, from _____ feet to _____ feet for each plug set.

1/4 sack hulls & wooden plug set @ 200'
Mixed 25 sacks cement through drill pipe
1/2 sack hulls & wooden plug set @ 40'
Mixed 10 sacks cement through drill pipe
1/2 sack cement in rat hole

REC 20
12-28-1986

Name of Plugging Contractor Chief Drilling Co., Inc. (If additional description is necessary, use BACK of this sheet)
Address Box 797 - Gt. Bend, Kansas 67530

STATE OF KANSAS, COUNTY OF BARTON, ss.
V. Richard Hoover (employee of owner) or (owner or operator) of the above-described well, being first duly sworn on oath, says: That I have knowledge of the facts, statements, and matters herein contained and the log of the above-described well as filed and that the same are true and correct. So help me God.

(Signature) V. Richard Hoover
Box 797 - Gt. Bend, Kansas 67530
(Address)

SUBSCRIBED AND SWORN to before me this 24th day of December, 19 66

My commission expires December 12, 1970

Carmen R. Cook
Carmen R. Cook, Notary Public.

15-167-30297-00-00

RECEIVED
STATE CORPORATION COMMISSION
12-28-1966
DEC 28 1966

WELL LOG

Chief Drilling Co., Inc.
Box 797
Great Bend, Kansas 67530

SPEERE #1
SW NE NE Sec. 23-13S-14W
Russell County, Kansas

Contractor: Chief Drilling Co., Inc.

Commenced: 12-13-66
Completed: 12-21-66

Casing Record: 205' of 8-5/8" w/135 sacks cement.

DRY & ABANDONED

<u>FORMATION</u>	<u>FROM</u>	<u>TO</u>	<u>ELEVATION</u>
Rock & Shale	0	207	1813 Gr.
Shale, Shells & Sand Streaks	207	305	1815 D.F.
Shale	305	348	1818 K.B.
Hard Sandy Lime	348	387	
Shale	387	818	
Anhydrite	818	857	
Shale	857	999	
Shale & Shells	999	1480	
Shale & Lime	1480	1800	
Lime & Shale Streaks	1800	1940	
Lime & Shale	1940	2685	
Lime	2685	2912	
Shale & Lime	2912	2944	
Shale & Sand	2944	2969	
Lime	2969	3257	
Dolomite	3257	3280	
Total Depth	3280		

FORMATION TOPS

Anhydrite	818	+1000
Topeka	2685	- 867
Heebner	2912	-1094
Toronto	2932	-1114
Douglas	2944	-1126
Lansing	2969	-1151
Arbuckle	3257	-1439
Total Depth	3280	-1462

STATE OF KANSAS, COUNTY OF BARTON) SS

I hereby certify that the above is a true and correct copy of the Driller's Log of the well drilled in the SW NE NE Section 23-13S-14W, Russell County, Kansas, to the best of my knowledge and belief.

CHIEF DRILLING CO., INC.

V. Richard Hoover
V. Richard Hoover, President

Subscribed and sworn to before me this 26th day of December, 1966.

Carmen R. Cook
Carmen R. Cook, Notary Public

My commission expires: December 12, 1970.