


15-167-00014-00-00  
WELL PLUGGING RECORD

Give All Information Completely  
Make Required Affidavit  
Mail or Deliver Report to:  
Conservation Division  
State Corporation Commission  
800 Bittling Building  
Wichita, Kansas

Russell County, Sec. 23 Twp. 13 Rge. 14 (E) W (W)  
Location as "NE/CNW $\frac{1}{4}$ SW $\frac{1}{4}$ " or footage from lines SE $\frac{1}{4}$  SW $\frac{1}{4}$  NE $\frac{1}{4}$   
Lease Owner Barnett Drilling, Inc., et al.  
Lease Name Speere Well No. 1  
Office Address 623 First National Bank Bldg., Wichita, 2, Kansas  
Character of Well (completed as Oil, Gas or Dry Hole) Dry Hole  
Date well completed January 30, 1952  
Application for plugging filed January 30, 1952  
Application for plugging approved January 30, 1952  
Plugging commenced January 30, 1952  
Plugging completed January 30, 1952  
Reason for abandonment of well or producing formation Dry Hole

NORTH

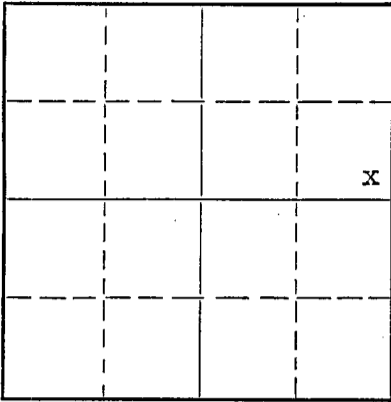

Locate well correctly on above Section Plat

If a producing well is abandoned, date of last production 19...  
Was permission obtained from the Conservation Division or its agents before plugging was commenced? Yes.

Name of Conservation Agent who supervised plugging of this well Eldon Petty  
Producing formation... Depth to top... Bottom... Total Depth of Well 3300 Feet  
Show depth and thickness of all water, oil and gas formations.

OIL, GAS OR WATER RECORDS

CASING RECORD

Formation	Content	From	To	Size	Put In	Pulled Out
		-0-	188'	8 5/8"	188'	-0-

Describe in detail the manner in which the well was plugged, indicating where the mud fluid was placed and the method or methods used in introducing it into the hole. If cement or other plugs were used, state the character of same and depth placed, from... feet to... feet for each plug set.

Filled hole with heavy mud from 3300 to 185 feet. Filled with one-half sack of hulls and 15 sacks of cement to 135 feet. Filled with heavy mud to 10 feet. Dumped one-half sack of hulls on plug and filled to bottom of cellar with 10 sacks of cement.

02-05-1952

(If additional description is necessary, use BACK of this sheet)

Name of Plugging Contractor Barnett Drilling, Inc.  
Address 623 First National Bank Bldg., Wichita 2, Kansas

STATE OF Kansas, COUNTY OF Sedgwick, ss.  
F. R. Stubblefield (employee of owner) or (owner or operator) of the above-described well,

being first duly sworn on oath, says: That I have knowledge of the facts, statements, and matters herein contained and the log of the above-described well as filed and that the same are true and correct. So help me God.

(Signature) F. R. Stubblefield

623 First National Bank Bldg., Wichita, Ks.  
(Address)

SUBSCRIBED AND SWORN to before me this 14th day of February, 1952.

Notary Public

My commission expires May 31, 1954

PLUGGING  
FILE 23 T 13 R 14C  
MAY 1952

15-167-00014-00-00

BARNETT DRILLING, INC.  
LOG OF SPEERE WELL NO. 1  
SE 1/4 SE 1/4 NE 1/4 SECTION 23-13-11W, RUSSELL COUNTY, KANSAS

*C. Skeck*

DATE COMMENCED: December 17, 1951

DATE COMPLETED: January 30, 1952

*Fidelity Union State*

Formation	From	To	Remarks
Surface	0	20	
Sand and Sandy Shale	20	30	
Post Rock	30	50	
Shale	50	110	
Shale and Shells	110	190	Set 8 5/8" surface pipe @ 188 feet; Cemented with 100 sacks.
Shale	190	360	
Pyrite and Shale	360	370	
Pyrite and Sand	370	425	
Sand	425	660	
Sand and Shale	660	825	
Shale and Shells	825	1175	
Sandy Shale	1175	1195	
Sand and Shale	1195	1575	
Shale and Lime	1575	1905	
Lime	1905	2010	
Lime and Shale	2010	2330	
Sand and Lime	2330	2445	
Shale and Lime	2445	2665	
Lime	2665	2725	
Lime and Shale	2725	2780	
Lime	2780	3277	
Arbuckle	3277	3295	
Lime	3295	3300	
Total Depth		3300	Dry and Abandoned.

CERTIFICATE

I, F. R. Stubblefield, of Barnett Drilling, Inc., hereby certify that to the best of my knowledge and belief, the above is a true and correct log of the Speere Well No. 1, located in the SE 1/4 SE 1/4 NE 1/4 of Section 23-13-11W, Russell County, Kansas.

*F. R. Stubblefield*

Subscribed and sworn to before me, in and for the County of Sedgwick, State of Kansas, this 4th day of February 1952.

*Madison G. [Signature]*  
Notary Public

My commission expires 5-31-54

PLUGGING  
FILE SEC-23-T-13-R-14W  
BOOK PAGE 142 OF 5

RECEIVED  
FEB 5 1952  
02-05-1952  
MISSOURI  
KANSAS

*C. Skeck*

*Fidelity Union State*