


Give All Information Completely
Make Required Affidavit
Mail or Deliver Report to:
Conservation Division
State Corporation Commission
211 No. Broadway
Wichita, Kansas

15-167-00345-00-00
WELL PLUGGING RECORD

NORTH

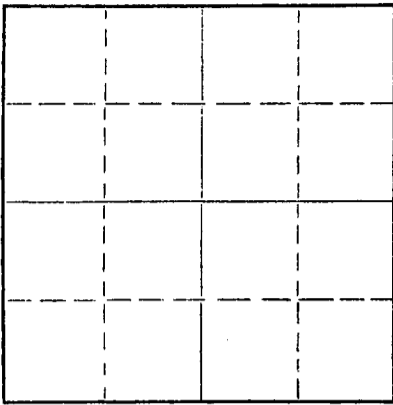

Locate well correctly on above
Section Plat

Russell County. Sec. 23 Twp. 13 Rge. 14W (E) (W)

Location as "NE/CNWxSWx" or footage from lines NE NW NW

Lease Owner Vye-Mallonee

Lease Name Dumler Well No. 1

Office Address 820 Union Center, Wichita, Kansas

Character of Well (completed as Oil, Gas or Dry Hole) Dry Hole

Date well completed 1-12 19 58

Application for plugging filed 1-12 19 58

Application for plugging approved 1-12 19 58

Plugging commenced 1-12 19 58

Plugging completed 1-12 19 58

Reason for abandonment of well or producing formation _____

If a producing well is abandoned, date of last production _____ 19 _____

Was permission obtained from the Conservation Division or its agents before plugging was commenced? yes

Name of Conservation Agent who supervised plugging of this well Don Truon

Producing formation _____ Depth to top _____ Bottom _____ Total Depth of Well 3332 Feet

Show depth and thickness of all water, oil and gas formations.

OIL, GAS OR WATER RECORDS

CASING RECORD

FORMATION	CONTENT	FROM	TO	SIZE	PUT IN	PULLED OUT
		0	217	8-5/8	217	None - cement circulated

Describe in detail the manner in which the well was plugged, indicating where the mud fluid was placed and the method or methods used in introducing it into the hole. If cement or other plugs were used, state the character of same and depth placed, from _____ feet to _____ feet for each plug set.

Drilling mud from bottom of hole to 240', plug set at 240', 1/2 sack hulls, 30 sacks cement. Mud to 40', plug set at 40', 1/2 sack hulls, 10 sacks cement to surface of hole.

RECEIVED
STATE CORPORATION COMMISSION
JAN 22 1958
01-22-1958
CONSERVATION DIVISION

(If additional description is necessary, use BACK of this sheet)
Name of Plugging Contractor Mallonee Drilling Company, Inc.
Address 820 Union Center, Wichita, Kansas

STATE OF KANSAS, COUNTY OF SEDGWICK, ss.
R. E. Mallonee (employee of owner) or (owner or operator) of the above-described well, being first duly sworn on oath, says: That I have knowledge of the facts, statements, and matters herein contained and the log of the above-described well as filed and that the same are true and correct. So help me God.

(Signature) R. E. Mallonee
820 Union Center, Wichita, Kansas
(Address)

SUBSCRIBED AND SWORN TO before me this 16th day of January, 19 58
Martha Lopez Notary Public.

My commission expires December 14, 1961

PLUGGING
FILE SEC 23 T 13 R 14W
BOOK PAGE 76 LINE 33

15-167-00345-00-00

DRILLERS' LOG
#1 Dumler
NE NW NW Sec. 23-13-14W
Russell County, Kans.

OWNER: Vye-Mallonee
CONTRACTOR: Mallonee Drilling Company, Inc.

COMMENCED: 12-30-57
COMPLETED: 1-12-58

D & A

FROM	TO	DESCRIPTION
0	50	Rock and clay
50	340	Shale and shells
340	500	Sand and iron
500	620	Shale
620	835	Red bed
835	875	Anhydrite
875	1500	Shale and shells
1500	1690	Lime and shale
1690	1995	Lime
1995	2105	Lime and shale
2105	2155	Lime
2155	2285	Shale, lime, shells
2285	2353	Shale and shells
2353	2500	Shale and lime
2500	2540	Lime
2540	2670	Lime and shale
2670	2900	Lime
2900	2955	Lime and shale
2955	3275	Lime
3275	3305	Lime and chert
3305	3332	Lime
3332		Rotary Total Depth

CASING RECORD

8-5/8" surface casing set at 217' with 135 sacks common cement. Cement circulated.

Drill Stem Test #1, 2292 - 3014
Open 1/2 hour, recovered 8' mud.
BHP 82#

Elevation		1824 KB
Tarkio Sand	2398	- 574
Tarkio Lime	2438	- 614
Heebner	2934	-1110
Toronto	2955	-1131
Lansing	2990	-1166
Base K.C.	3256	-1432
Cherty Conglomerate	3288	-1464
Arbuckle	3320	-1496
T.D.	3332	-1508

Geologist: Robert D. Gensch

I hereby certify that the above is a true and accurate Drillers' Log of the captioned well, to the best of my knowledge and belief.

R. E. Mallonee
R. E. Mallonee

State of Kansas)
County of Sedgwick) ss

Subscribed and sworn to before me this 21st day of January, 1958.

My commission expires:
December 14, 1961

Martha Gorges
Notary Public (Martha Gorges)

PLUGGING
NE NW NW SEC 23 T 13 R 14 W
BOOK PAGE 76 LINE 33

RECEIVED
STATE CORPORATION COMMISSION
01-22-1958
JAN 22 1958
CONFEE