


STATE OF KANSAS  
STATE CORPORATION COMMISSION  
Give All Information Completely  
Make Required Affidavit  
Mail or Deliver Report to:  
Conservation Division  
State Corporation Commission  
212 North Market, Insurance Bldg.  
Wichita, Kansas

WELL PLUGGING RECORD

NORTH

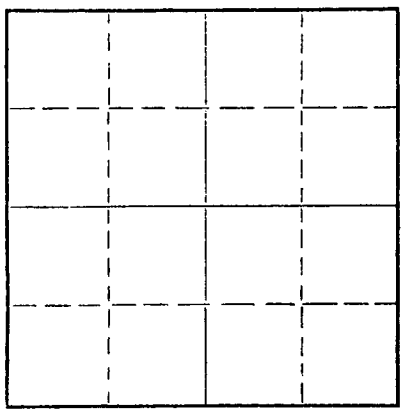

Locate well correctly on above Section Plat

Russell County. Sec. 23 Twp. 13 Rge. 14 (E) (W)X  
Location as "NE/CNWxSWx" or footage from lines SE SW SW  
Lease Owner Sierra Petroleum Co., Inc.  
Lease Name Dumler Well No. #5  
Office Address 208 Petroleum Bldg., Wichita, Kansas  
Character of Well (completed as Oil, Gas or Dry Hole) Oil  
Date well completed \_\_\_\_\_ 19\_\_\_\_  
Application for plugging filed 10-31-61 19\_\_\_\_  
Application for plugging approved \_\_\_\_\_ 19\_\_\_\_  
Plugging commenced 10-28-61 19\_\_\_\_  
Plugging completed 11-1-61 19\_\_\_\_  
Reason for abandonment of well or producing formation dry  
If a producing well is abandoned, date of last production \_\_\_\_\_ 19\_\_\_\_  
Was permission obtained from the Conservation Division or its agents before plugging was commenced? \_\_\_\_\_

Name of Conservation Agent who supervised plugging of this well Donald Truan  
Producing formation \_\_\_\_\_ Depth to top \_\_\_\_\_ Bottom \_\_\_\_\_ Total Depth of Well 3272' Feet  
Show depth and thickness of all water, oil and gas formations.

OIL, GAS OR WATER RECORDS

CASING RECORD

FORMATION	CONTENT	FROM	TO	SIZE	PUT IN	PULLED OUT

Describe in detail the manner in which the well was plugged, indicating where the mud fluid was placed and the method or methods used in introducing it into the hole. If cement or other plugs were used, state the character of same and depth placed, from \_\_\_\_\_ feet to \_\_\_\_\_ feet for each plug set.

Sanded back to 3250' with 1/4 sacks cement.  
Pulled casing  
Mixed and ran 80 sacks cement to plug hole.

RECEIVED  
STATE CORPORATION COMMISSION  
NOV 3 1961  
CONSERVATION DIVISION  
WICHITA, KANSAS

(If additional description is necessary, use BACK of this sheet)

Name of Plugging Contractor Southwest Casing Pulling Co., Inc.  
Address Box 364, Great Bend, Kansas

STATE OF Kansas, COUNTY OF Barton, ss.  
Southwest Casing Pulling Co., Inc. (employee of owner) or (owner or operator) of the above-described well, being first duly sworn on oath, says: That I have knowledge of the facts, statements, and matters herein contained and the log of the above-described well as filed and that the same are true and correct. So help me God.

(Signature) W. C. Spencer  
Box 364, Great Bend, Kansas  
(Address)

SUBSCRIBED AND SWORN TO before me this 1 day of Nov., 19 61

My commission expires 24 October 1964 Sidney D. Miller Notary Public.



15-167-01928-00-00

B & R Drilling, Inc.  
Dialer #5

SE SW SW 23-13-14  
Russell Co., Kans.

Total Depth: 3272'  
Comm. 3/12/52  
Comp. 3/24/52

Casing

8 5/8" Set @ 197'  
5 1/2" Set @ 3271

Cement

130 sacks Lone Star  
100 sacks of Ash Grove

Formation

Depth

Top soil-sand	45
Shale-sand	150
Shale-shells	250
Sand-pyrite	360
Pyrite	410
Shale-pyrite	440
Shale-shells	478
Shale-shells	515
Red Bed	730
Red bed-shale	860
Anhydrite	895
Red bed-shale	1225
Salt-shale	1540
Lime-shale	2380
Sand-lime	2705
Lime	2869
Lime-shale	2915
Lime	3272'

State of Kansas )  
Russell County ) ss

I hereby certify that the above information is true and correct to the best of my knowledge.

-----  
*Cora B. [Signature]*  
-----

Subscribed and sworn to before me this 31st day of March, 1952.

-----  
Notary Public  
-----

My commission expires: 6-17-54

RECEIVED  
STATE CORPORATION COMMISSION

OCT 26 1961  
10-26-1961  
CONSERVATION DIVISION  
Wichita, Kansas