


STATE OF KANSAS  
STATE CORPORATION COMMISSION

WELL PLUGGING RECORD

Give All Information Completely  
Make Required Affidavit  
Mail or Deliver Report to  
Conservation Division  
State Corporation Comm.  
245 North Water  
Wichita, KS 67202

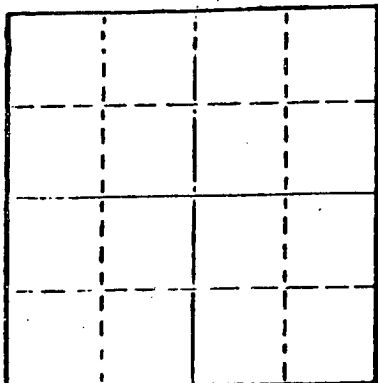

Locate well correctly on above  
Section Plat

Russell County, Sec. 24 Twp. 13S Rge. 14W E/W  
Location as "NE/CNW $\frac{1}{4}$ SW $\frac{1}{4}$ " or footage from lines  
1320' N. of S. Line 1650' E of W. Line  
Lease Owner Willard M. Glasco  
Lease Name Krug Well No. 1  
Office Address 5432 Plaza Lane, Wichita, Kansas  
Character of Well (Completed as Oil, Gas or Dry Hole)  
Dry Hole  
Date Well completed 8-21 1977  
Application for plugging filed 8-21 1977  
Application for plugging approved 8-21 1977  
Plugging commenced 3:15 P.M. 8-21 1977  
Plugging completed 7:15 P.M. 8-21 1977  
Reason for abandonment of well or producing formation  
Dry Hole

If a producing well is abandoned, date of last production  
None 19

Was permission obtained from the Conservation Division or  
its agents before plugging was commenced? Yes

Name of Conservation Agent who supervised plugging of this well Duane Rankin  
Producing formation None Depth to top Bottom Total Depth of Well 3335'  
Show depth and thickness of all water, oil and gas formations.

OIL, GAS OR WATER RECORDS

8 5/8 @ 224'

CASING RECORD

FORMATION	CONTENT	FROM	TO	SIZE	PUT IN	PULLED OUT

Describe in detail the manner in which the well was plugged, indicating where the mud fluid  
was placed and the method or methods used in introducing it into the hold. If cement or other  
plugs were used, state the character of same and depth placed, from \_\_\_\_\_ feet to  
\_\_\_\_\_ feet for each plug set.

Filled Hole with heavy mud.  
Mixed 50 sacks cement, pumped in hole @ 500'  
Mixed 25 sacks cement, pumped in hole @ 210'  
Set Plug @ 40' Pumped in hole to bottom of cellar.  
Cement used was 50-50 % Poz mix with 2% gel.

RECEIVED  
STATE CORPORATION COMMISSION  
AUG 23 1977  
08-23-1977  
CONSERVATION DIVISION  
Wichita, Kansas

(If additional description is necessary, use BACK of this sheet)

Name of Plugging Contractor Revlin Drlg., Inc.  
Box 88, Russell, Kansas 67665

STATE OF Kansas COUNTY OF Russell ss.

S. C. Lingreen (employee of owner) or (owner or operator) of the above-described


well, being first duly sworn on oath, says: That I have knowledge of the facts, statements, and matters herein contained and the log of the  
above-described well as filed and that the same are true and correct. So help me God.

(Signature) Stanley C. Lingreen  
Box 88, Russell, Kansas 67665  
(Address)

SUBSCRIBED AND SWORN TO before me this 22nd day of August 1977

My commission expires January 29th 1981

Lauraine Sullivan  
Notary Public.

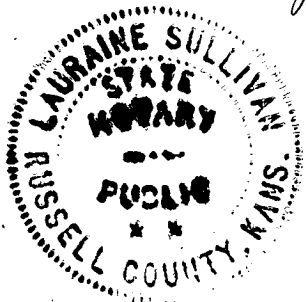



15-1167-21078-00-00

DON J. REVELL 913-483-4022  
STANLEY C. LINGREEN 913-368-4516

OFFICE PHONE 913-483-5355

Drilled for Willard M. Glasco  
5432 Plaza Lane  
Wichita, Kansas

BOX 88  
RUSSELL, KANSAS 67665  
Well: Krug #1  
1320' N. of S. Line  
1650' E. of W. Line  
Sec. 24, Twp. 13S, Rge. 14W  
Russell County, Kansas

Drilling Log

8-15-77 Evening Tower  
0'-225' Sand & Shale

8-16-77 Morning Tower  
225'-382' Red Shale Iron

Daylight Tower  
382'-570' Iron

Evening Tower  
570'-845' Red Bed & Shale  
845'-880' Anhydrite  
880'-1268' Shale

8-20-77 Morning Tower  
3103'-3137' Lime

Daylight Tower  
3137'-3177' Lime

Evening Tower  
3177'-3220' Lime

8-21-77 Morning Tower  
3220'-3244' Lime

Daylight Tower  
3244'-3335' Lime

8-17-77 Morning Tower  
1268'-1585' Shale

Daylight Tower  
1585'-1852' Ft. Riley

Evening Tower  
1852'-2050' Lime

8-18-77 Morning Tower  
2050'-2362' Shale Lime

Daylight Tower  
2362'-2665' Shale Lime

Evening Tower  
2665'-2823' Shale & Lime

8-19-77 Morning Tower  
2823'-2915' Lime

Daylight Tower  
2915'-3032' Lime

Evening Tower  
3032'-3103' Lime

RECEIVED  
STATE CORPORATION COMMISSION

AUG 23 1977  
08-23-1977  
CORPORATION DIVISION  
Wichita, Kansas