

CARD MUST BE TYPED

State of Kansas
NOTICE OF INTENTION TO DRILL
(see rules on reverse side)

CARD MUST BE SIGNED

Starting Date:9-23-84.....
month day year

API Number 15- 167-22,4680000

OPERATOR: License # ...9860.....

.....SE. NE SW. Sec . 13. Twp 13. S, Rge 15 .. East
(location) West

NameCastle Resources.....

Address RR...1. Stonewood Estates.....

..1650..... Ft North from Southeast Corner of Section

City/State/Zip Lot .8, Hays Ks....67601.....

..2970..... Ft West from Southeast Corner of Section

Contact Person Jerry Green.....

(Note: Locate well on Section Plat on reverse side)

Phone913.625-5155.....

Nearest lease or unit boundary line330..... feet.

CONTRACTOR: License #5381.....

CountyRussell.....

NameBig Springs Drilling.....

Lease NameBieker..... Well# ..1.....

City/StateWichita, KS.....

Domestic well within 330 feet : yes no

Well Drilled For: Well Class: Type Equipment:

Municipal well within one mile : yes no

Oil Swd Infield Mud Rotary

Depth to Bottom of fresh water75..... feet

Gas Inj Pool Ext. Air Rotary

Lowest usable water formationDakota.....

OWWO Expl Wildcat Cable

Depth to Bottom of usable water600..... feet

If OWWO: old well info as follows:

Surface pipe by Alternate : 1 2

Operator

Surface pipe to be set200..... feet

Well Name

Conductor pipe if any required feet

Comp Date Old Total Depth

Ground surface elevation feet MSL

Projected Total Depth3275..... feet


Projected Formation at TDArbuckle.....

Approved By9-12-84.....

Expected Producing Formations

I certify that we will comply with K.S.A. 55-101, et seq., plus eventually plugging hole to K.C.C. specifications.

Date9-12-84 Signature of Operator or Agent

John Hicks

Title AS Agent

MHC/KOHE 9/12/84

Must be filed with the K.C.C. five (5) days prior to commencing well
 This card void if drilling not started within six (6) months of date received by K.C.C.

CONSERVATION DIVISION
 Wichita, Kansas

SEP 17 1984


Important procedures to follow :

1. Notify District office before setting surface casing.
2. Set surface casing by circulating cement to the top.
3. File completion forms ACO-1 with K.C.C. within 90 days of well completion, following instructions on ACO-1, side 1, and including copies of wireline logs.
4. Notify District office 48 hours prior to old well workover or re-entry.
5. Prior to plugging, prepare a plugging plan, then obtain agreement from the appropriate district office for an approved plugging plan.
6. Submit plugging report (CP-4) to K.C.C. after plugging is completed.
7. Obtain an approved injection docket number before disposing of salt water.
8. Notify K.C.C. within 10 days when injection commences or terminates.
9. If an alternate 2 completion, cement in the production pipe from below any usable water to surface within 120 days of spud date.

REGULAR SECTION OF LAND



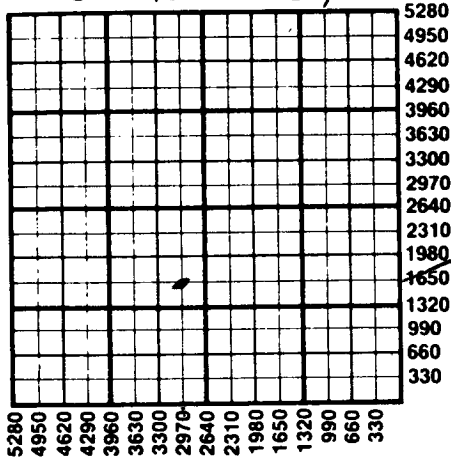

State Corporation Commission of Kansas
 Conservation Division
 200 Colorado Derby Building
 Wichita, Kansas 67202
 (316) 263-3238